

**WATER WELL PLUGGING RECORD Form WWC-5P**

KSA 82a-1212 ID NO.

ISCO-C-2

**1 LOCATION OF WATER WELL:** Fraction  $\frac{1}{4}$   $\frac{1}{4}$  NW  $\frac{1}{4}$   $\frac{1}{4}$  Section Number 31 Township Number T 9 S Range Number 11  E  W  
 County: Pottawatomie

Street/Rural Address of Well Location: if unknown, distance & direction from nearest town or intersection: If at owner's address, check here

16795 Say Rd, Wamego, KS 66547

**Global Positioning Systems (GPS) information:**

Latitude: 39.222475 (in decimal degrees)

Longitude: 96.326384 (in decimal degrees)

Elevation: 1115.52

Datum:  WGS84,  NAD83,  NAD27

**Collection Method:**


GPS unit (Make/Model: iPhone 5C

Digital Map/Photo,  Topographic Map,  Land Survey

Est. Accuracy:  < 3 m,  3-5 m,  5-15 m,  > 15 m

**2 WATER WELL OWNER:** U.S. Army Corps of Eng.  
 RR#, St. Address, Box #: 601 East 12th ST  
 City, State ZIP Code: Kansas City, MO 64106

**3 MARK WELL'S LOCATION WITH AN "X" IN SECTION BOX:**

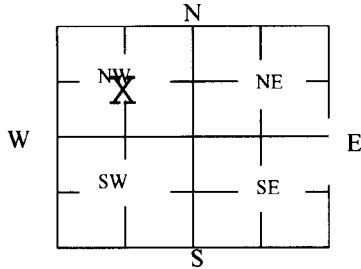

**4 DEPTH OF WELL** 119 ft.

WELL'S STATIC WATER LEVEL 104.80 ft

**WELL WAS USED AS:**

- Domestic
- Irrigation
- Feedlot
- Industrial
- Public Water Supply
- Oil Field Water Supply
- Domestic (Lawn & Garden)
- Air Conditioning
- Dewatering
- Monitoring
- Injection Well
- Other ISCO

Was a chemical/bacteriological sample submitted to Department? Yes  No

**5 TYPE OF BLANK CASING USED:**

- Steel
- PVC
- RMP (SR)
- ABS
- Wrought
- Asbestos-Cement
- Fiberglass
- Concrete Tile
- Other (Specify below) \_\_\_\_\_

Blank casing diameter 4 in. Was casing pulled? Yes  No  If yes, how much \_\_\_\_\_  
 Casing height above or below land surface 30 in.

**6 GROUT PLUG MATERIAL:**  Neat cement  Cement grout  Bentonite  Other \_\_\_\_\_

Grout Plug Intervals: From \_\_\_\_\_ ft. to \_\_\_\_\_ ft., From \_\_\_\_\_ ft. to \_\_\_\_\_ ft., From \_\_\_\_\_ to \_\_\_\_\_ ft.

**What is the nearest source of possible contamination:**

- Septic tank
  - Sewer lines
  - Watertight sewer lines
  - Lateral lines
  - Cess pool
  - Seepage pit
  - Pit privy
  - Sewage lagoon
  - Feedyard
  - Livestock pens
  - Fuel Storage
  - Fertilizer storage
  - Insecticide storage
  - Abandoned water well
  - Oil well/Gas well
  - Other (specify below) Unknown \_\_\_\_\_
- Direction from well? \_\_\_\_\_  
 How many feet? \_\_\_\_\_

FROM	TO	PLUGGING MATERIALS	FROM	TO	PLUGGING MATERIALS
0	119	Neat Cement			

**7 CONTRACTOR'S OR LANDOWNER'S CERTIFICATION:** This water well was plugged under my jurisdiction and was completed on (mo/day/year) 11-1-14 and this record is true to the best of my knowledge and belief. Kansas Water Well Contractor's License No. 597. This Water Well Record was completed on (mo/day/year) 11-1-14 under the business name of Cascade Drilling, L.P. by (signature) *[Signature]*

**INSTRUCTIONS:** Use typewriter or ballpoint pen. Please press firmly and print clearly. Please fill in blanks, underline or circle the correct answers. Send one copy to Kansas Department of Health and Environment, Bureau of Water, Geology Section, 1000 SW Jackson St., Ste. 420, Topeka, Kansas 66612-1367. Telephone: 785/296-5524. Send one to Water Well Owner and retain one for your records. Visit us at <http://www.kdheks.gov/waterwell/index.html>.