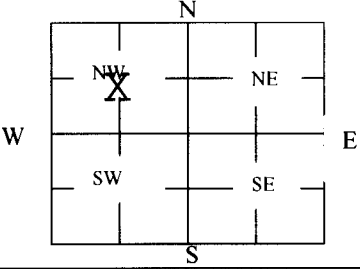


**WATER WELL PLUGGING RECORD Form WWC-5P**

KSA 82a-1212 ID NO.

VE-6

|  |                                       |   |                                 |  |
|--|---------------------------------------|---|---------------------------------|--|
| <b>1 LOCATION OF WATER WELL:</b><br>County: <u>Pottawatomie</u>  | Fraction<br><u>1/4 1/4 NW 1/4 1/4</u> | Section Number<br><u>31</u>   | Township Number<br><u>T 9 S</u> | Range Number<br><u>11</u> <input checked="" type="checkbox"/> E <input type="checkbox"/> W |
| Street/Rural Address of Well Location: if unknown, distance & direction from nearest town or intersection: If at owner's address, check here <input type="checkbox"/><br><br><u>16795 Say Rd, Wamego, KS 66547</u> |                                       | <b>Global Positioning Systems (GPS) information:</b><br>Latitude: <u>39.222223</u> (in decimal degrees)<br>Longitude: <u>96.326171</u> (in decimal degrees)<br>Elevation: <u>1115.92</u><br>Datum: <input checked="" type="checkbox"/> WGS84, <input type="checkbox"/> NAD83, <input type="checkbox"/> NAD27<br>Collection Method:<br><input checked="" type="checkbox"/> GPS unit (Make/Model: <u>iPhone 5C</u> )<br><input type="checkbox"/> Digital Map/Photo, <input type="checkbox"/> Topographic Map, <input type="checkbox"/> Land Survey<br>Est. Accuracy: <input type="checkbox"/> < 3 m, <input type="checkbox"/> 3-5 m, <input type="checkbox"/> 5-15 m, <input type="checkbox"/> > 15 m |                                 |  |
| <b>2 WATER WELL OWNER:</b> U.S. Army Corps of Eng.<br>RR#, St. Address, Box #: <u>601 East 12th ST</u><br>City, State ZIP Code: <u>Kansas City, MO 64106</u>   |                                       |   |                                 |  |

|  |  |
|--|--|
| <b>3 MARK WELL'S LOCATION WITH AN "X" IN SECTION BOX:</b><br> | <b>4 DEPTH OF WELL</b> <u>73</u> ft.<br>WELL'S STATIC WATER LEVEL <u>68.80</u> ft<br>WELL WAS USED AS:<br><input type="checkbox"/> Domestic <input type="checkbox"/> Public Water Supply <input type="checkbox"/> Dewatering<br><input type="checkbox"/> Irrigation <input type="checkbox"/> Oil Field Water Supply <input type="checkbox"/> Monitoring<br><input type="checkbox"/> Feedlot <input type="checkbox"/> Domestic (Lawn & Garden) <input checked="" type="checkbox"/> Injection Well<br><input type="checkbox"/> Industrial <input type="checkbox"/> Air Conditioning <input type="checkbox"/> Other <u>VE</u><br>Was a chemical/bacteriological sample submitted to Department? Yes <input type="checkbox"/> No <input checked="" type="checkbox"/> |
|--|--|

**5 TYPE OF BLANK CASING USED:**

Steel  RMP (SR)  Wrought  Fiberglass  Other (Specify below) \_\_\_\_\_  
 PVC  ABS  Asbestos-Cement  Concrete Tile \_\_\_\_\_

Blank casing diameter 4 in. Was casing pulled? Yes  No  If yes, how much \_\_\_\_\_  
 Casing height above or below land surface 30 in.

**6 GROUT PLUG MATERIAL:**  Neat cement  Cement grout  Bentonite  Other \_\_\_\_\_

Grout Plug Intervals: From \_\_\_\_\_ ft. to \_\_\_\_\_ ft., From \_\_\_\_\_ ft. to \_\_\_\_\_ ft., From \_\_\_\_\_ to \_\_\_\_\_ ft.

What is the nearest source of possible contamination:  
 Septic tank  Seepage pit  Fuel Storage  Other (specify below) \_\_\_\_\_  
 Sewer lines  Pit privy  Fertilizer storage  Unknown \_\_\_\_\_  
 Watertight sewer lines  Sewage lagoon  Insecticide storage \_\_\_\_\_  
 Lateral lines  Feedyard  Abandoned water well Direction from well? \_\_\_\_\_  
 Cess pool  Livestock pens  Oil well/Gas well How many feet? \_\_\_\_\_

| FROM | TO | PLUGGING MATERIALS | FROM | TO | PLUGGING MATERIALS |
|------|----|--------------------|------|----|--------------------|
| 0    | 73 | Neat Cement        |      |    |                    |
|      |    |                    |      |    |                    |
|      |    |                    |      |    |                    |
|      |    |                    |      |    |                    |
|      |    |                    |      |    |                    |

**7 CONTRACTOR'S OR LANDOWNER'S CERTIFICATION:** This water well was plugged under my jurisdiction and was completed on (mo/day/year) 11-3-14 and this record is true to the best of my knowledge and belief. Kansas Water Well Contractor's License No. 597. This Water Well Record was completed on (mo/day/year) 11-3-14 under the business name of Cascade Drilling, L.P. by (signature) [Signature]

**INSTRUCTIONS:** Use typewriter or ballpoint pen. Please press firmly and print clearly. Please fill in blanks, underline or circle the correct answers. Send one copy to Kansas Department of Health and Environment, Bureau of Water, Geology Section, 1000 SW Jackson St., Ste. 420, Topeka, Kansas 66612-1367. Telephone: 785/296-5524. Send one to Water Well Owner and retain one for your records. Visit us at <http://www.kdheks.gov/waterwell/index.html>.