

WATER WELL PLUGGING RECORD Form WWC-5P

KSA 82a-1212 ID NO.

WR-4


1 LOCATION OF WATER WELL: County: Pottawatomie	Fraction ne 1/4 sw 1/4 nw 1/4	Section Number 12	Township Number T 9 S	Range Number 11 <input checked="" type="checkbox"/> E <input type="checkbox"/> W
---	---	-----------------------------	---------------------------------	--

Street/Rural Address of Well Location; if unknown, distance & direction from nearest town or intersection: If at owner's address, check here **Jeffrey Energy Center**

Global Positioning Systems (GPS) information:
 Latitude: **39.282614** (in decimal degrees)
 Longitude: **-96.142026** (in decimal degrees)
 Elevation: **1172**
 Horizontal Datum: WGS84. NAD83. NAD27
 Collection Method:

2 WATER WELL OWNER: **Westar Energy**
 RR#, St. Address, Box #: **818 S. Kansas Avenue**
 City, State ZIP Code: **Topeka, Kansas 66612**

GPS unit (Make/Model: **Garmin eTrex10**)
 Digital Map/Photo. Topographic Map. Land Survey
 Est. Accuracy: < 3 m. 3-5 m. 5-15 m. > 15 m

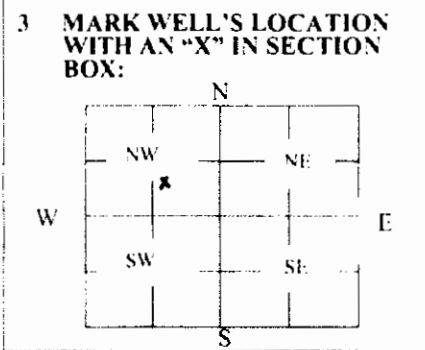

4 DEPTH OF WELL 34 ft.
 WELL'S STATIC WATER LEVEL 11 ft.
 WELL WAS USED AS:

<input type="checkbox"/> Domestic	<input type="checkbox"/> Public Water Supply	<input type="checkbox"/> Dewatering
<input type="checkbox"/> Irrigation	<input type="checkbox"/> Oil Field Water Supply	<input checked="" type="checkbox"/> Monitoring
<input type="checkbox"/> Feedlot	<input type="checkbox"/> Domestic (Lawn & Garden)	<input type="checkbox"/> Injection Well
<input type="checkbox"/> Industrial	<input type="checkbox"/> Air Conditioning	<input type="checkbox"/> Other _____

Was a chemical/bacteriological sample submitted to Department? Yes No

5 TYPE OF BLANK CASING USED:

<input type="checkbox"/> Steel	<input type="checkbox"/> RMP (SR)	<input type="checkbox"/> Wrought	<input type="checkbox"/> Fiberglass	<input type="checkbox"/> Other (Specify below) _____
<input checked="" type="checkbox"/> PVC	<input type="checkbox"/> ABS	<input type="checkbox"/> Asbestos-Cement	<input type="checkbox"/> Concrete Tile	

Blank casing diameter 2 in. Was casing pulled? Yes No If yes, how much 5' below ground surface
 Casing height above or below land surface _____ in.

6 GROUT PLUG MATERIAL: Neat cement Cement grout Bentonite Other _____

Grout Plug Intervals: From 0 ft. to 34 ft., From _____ ft. to _____ ft., From _____ ft. to _____ ft.

What is the nearest source of possible contamination:

<input type="checkbox"/> Septic tank	<input type="checkbox"/> Sepage pit	<input type="checkbox"/> Fuel storage	<input checked="" type="checkbox"/> Other (specify below)
<input type="checkbox"/> Sewer lines	<input type="checkbox"/> Pit privy	<input type="checkbox"/> Fertilizer storage	<u>Westar - Ash landfill</u>
<input type="checkbox"/> Watertight sewer lines	<input type="checkbox"/> Sewage lagoon	<input type="checkbox"/> Insecticide storage	
<input type="checkbox"/> Lateral lines	<input type="checkbox"/> Feedyard	<input type="checkbox"/> Abandoned water well	Direction from well? _____
<input type="checkbox"/> Cess pool	<input type="checkbox"/> Livestock pens	<input type="checkbox"/> Oil well/Gas well	How many feet? _____

FROM	TO	PLUGGING MATERIALS	FROM	TO	PLUGGING MATERIALS
0	34	Bentonite Chips			

7 CONTRACTOR'S OR LANDOWNER'S CERTIFICATION: This water well was plugged under my jurisdiction and was completed on (mo/day/year) 3/6/2017 and this record is true to the best of my knowledge and belief. Kansas Water Well Contractor's License No. 416. This Water Well Record was completed on (mo/day/year) 3/27/17 under the business name of Terracon Consultants, Inc. by (signature) [Signature]