

WATER WELL PLUGGING RECORD Form WWC-5P

KSA 82a-1212

ID NO.

WR-2


1 LOCATION OF WATER WELL: Fraction ne 1/4 sw 1/4 nw 1/4 1/4 Section Number 12 Township Number T 9 S Range Number 11 E W
 County: Pottawatomie

Street/Rural Address of Well Location: if unknown, distance & direction from nearest town or intersection: If at owner's address, check here Jeffrey Energy Center

Global Positioning Systems (GPS) information:
 Latitude: 39.283894 (in decimal degrees)
 Longitude: -96.141661 (in decimal degrees)
 Elevation: 1171
 Horizontal Datum: WGS84, NAD83, NAD27
 Collection Method:

2 WATER WELL OWNER: Westar Energy
 RR#, St. Address, Box #: 818 S. Kansas Avenue
 City, State ZIP Code: Topeka, Kansas 66612

GPS unit (Make Model: Garmin eTrex10)
 Digital Map Photo. Topographic Map. Land Survey
 Est. Accuracy: < 3 m. 3-5 m. 5-15 m. > 15 m

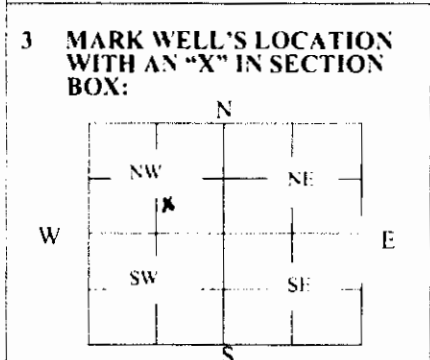

4 DEPTH OF WELL 44.5 ft.
 WELL'S STATIC WATER LEVEL 14 ft
 WELL WAS USED AS:
 Domestic Public Water Supply Dewatering
 Irrigation Oil Field Water Supply Monitoring
 Feedlot Domestic (Lawn & Garden) Injection Well
 Industrial Air Conditioning Other _____

Was a chemical/bacteriological sample submitted to Department? Yes No

5 TYPE OF BLANK CASING USED:

Steel RMP (SR) Wrought Fiberglass Other (Specify below) _____
 PVC ABS Asbestos-Cement Concrete Tile

Blank casing diameter 2 in. Was casing pulled? Yes No If yes, how much 5' below ground surface
 Casing height above or below land surface _____ in.

6 GROUT PLUG MATERIAL: Neat cement Cement grout Bentonite Other _____

Grout Plug Intervals: From 0 ft. to 45 ft., From _____ ft. to _____ ft., From _____ ft. to _____ ft.

What is the nearest source of possible contamination:
 Septic tank Seepage pit Fuel storage Other (specify below) Westar - Ash landfill
 Sewer lines Pit privy Fertilizer storage
 Watertight sewer lines Sewage lagoon Insecticide storage
 Lateral lines Feedyard Abandoned water well Direction from well? _____
 Cess pool Livestock pens Oil well/Gas well How many feet? _____

FROM	TO	PLUGGING MATERIALS	FROM	TO	PLUGGING MATERIALS
0	45	Bentonite Chips			

7 CONTRACTOR'S OR LANDOWNER'S CERTIFICATION: This water well was plugged under my jurisdiction and was completed on (mo/day/year) 3/6/2017 and this record is true to the best of my knowledge and belief. Kansas Water Well Contractor's License No. 416. This Water Well Record was completed on (mo/day/year) 3/27/17 under the business name of Terracon Consultants, Inc. by (signature) [Signature]

Send one white copy to Kansas Department of Health & Environment, Geology Section, 1000 SW Jackson Street, Ste. 420, Topeka, KS 66612-1367. Send one copy to WATER WELL OWNER and retain one for your records.
 Visit us at <http://www.kdheks.gov/waterwell/index.html> Telephone 785-296-5524.