


1 LOCATION OF WATER WELL: County: Pott Fracture: NE 1/4 NE 1/4 SW 1/4 Section Number: 26 Township Number: T 9 S Range Number: R 12 E

Distance and direction from nearest town or city street address of well if located within city? From St Marys Go 3 miles North on 63 & then 1 mile East on Dclin Rd.

2 WATER WELL OWNER: Don Hohman  
 RR#, St. Address, Box #: 311 N. 6th St.  
 City, State, ZIP Code: St Marys, KS 66536  
 Board of Agriculture, Division of Water Resources  
 Application Number:

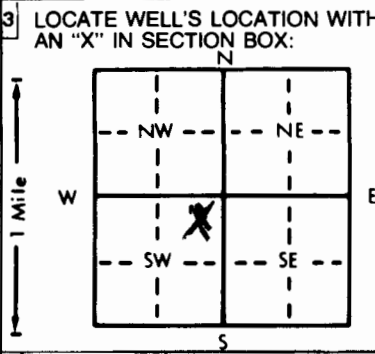

4 DEPTH OF COMPLETED WELL: 80 ft. ELEVATION: .....  
 Depth(s) Groundwater Encountered 1. 2.4 ft. 2. .... ft. 3. .... ft.  
 WELL'S STATIC WATER LEVEL 2.4 ft. below land surface measured on mo/day/yr .....  
 Pump test data: Well water was ..... ft. after ..... hours pumping ..... gpm  
 Est. Yield 2.5 gpm: Well water was ..... ft. after ..... hours pumping ..... gpm  
 Bore Hole Diameter: 9 in. to 80 in. to ..... in. to ..... ft.  
 WELL WATER TO BE USED AS: 5 Public water supply 8 Air conditioning 11 Injection well  
 Domestic 3 Feedlot 6 Oil field water supply 9 Dewatering 12 Other (Specify below)  
 2 Irrigation 4 Industrial 7 Lawn and garden only 10 Monitoring well  
 Was a chemical/bacteriological sample submitted to Department? Yes.....No.....; If yes, mo/day/yr sample was submitted  
 Water Well Disinfected?  Yes No

5 TYPE OF BLANK CASING USED: 5 Wrought iron 8 Concrete tile CASING JOINTS:  Glued ..... Clamped .....  
 1 Steel 3 RMP (SR) 6 Asbestos-Cement 9 Other (specify below)  Welded .....  
 PVC 4 ABS 7 Fiberglass ..... Threaded .....  
 Blank casing diameter 5 in. to 60 ft. Dia. .... in. to ..... ft. Dia. .... in. to ..... ft.  
 Casing height above land surface 2' in. weight Sch 40 lbs./ft. Wall thickness or gauge No. ....  
 TYPE OF SCREEN OR PERFORATION MATERIAL: 7 PVC 10 Asbestos-cement  
 1 Steel 3 Stainless steel 5 Fiberglass 8 RMP (SR) 11 Other (specify) .....  
 2 Brass 4 Galvanized steel 6 Concrete tile 9 ABS 12 None used (open hole)  
 SCREEN OR PERFORATION OPENINGS ARE: 3 Mill slot 25/1000's 8 Saw cut 11 None (open hole)  
 1 Continuous slot 4 Key punched 6 Wire wrapped 9 Drilled holes  
 2 Louvered shutter 7 Torch cut 10 Other (specify) .....  
 SCREEN-PERFORATED INTERVALS: From 60 ft. to 80 ft. From ..... ft. to ..... ft.  
 From ..... ft. to ..... ft. From ..... ft. to ..... ft.  
 GRAVEL PACK INTERVALS: From 2.4 ft. to 80 ft. From ..... ft. to ..... ft.  
 From ..... ft. to ..... ft. From ..... ft. to ..... ft.

6 GROUT MATERIAL: 1 Neat cement 2 Cement grout  Bentonite 4 Other .....  
 Grout Intervals: From 0 ft. to 2.4 ft. From ..... ft. to ..... ft. From ..... ft. to ..... ft.  
 What is the nearest source of possible contamination: None Close Pit privy  
 1 Septic tank 4 Lateral lines 10 Livestock pens 14 Abandoned water well  
 2 Sewer lines 5 Cess pool 11 Fuel storage 15 Oil well/Gas well  
 3 Watertight sewer lines 6 Seepage pit 8 Sewage lagoon 12 Fertilizer storage 16 Other (specify below)  
 9 Feedyard 13 Insecticide storage  
 Direction from well? How many feet?

FROM	TO	LITHOLOGIC LOG	FROM	TO	PLUGGING INTERVALS
0	1	Top Soil			
1	24	Brown Clay			
24	32	Limestone (water)			
32	38	Grey Shale			
38	45	Limestone			
45	51	Brown Shale			
51	59	Limestone			
59	62	Brown Shale			
62	68	Limestone			
68	80	Grey Shale			

7 CONTRACTOR'S OR LANDOWNER'S CERTIFICATION: This water well was  constructed,  reconstructed, or  plugged under my jurisdiction and was completed on (mo/day/year) 11/11/96 and this record is true to the best of my knowledge and belief. Kansas Water Well Contractor's License No. 451 This Water Well Record was completed on (mo/day/yr) 12/8/96 under the business name of Hohman Well Drilling by (signature) Craig