


USE TYPEWRITER OR BALL POINT PEN-PRESS FIRMLY, PRINT CLEARLY.

WATER WELL RECORD  
KSA 82a-1201-1215

Kansas Department of Health and Environment-Division of Environment  
(Water well Contractors)  
Topeka, Kansas 66620

1. Location of well: County POTTAWATOMIE Fraction NE 1/4 NE 1/4 NE 1/4 Section number 2 Township number T 9 S R 12 E/W Range number

2. Distance and direction from nearest town or city: 1 S 1 E  
Street address of well location if in city: OF EMMETT  
3. Owner of well: ART JENSEN RT 1  
 or street:  
City, state, zip code: EMMETT, KS 66422

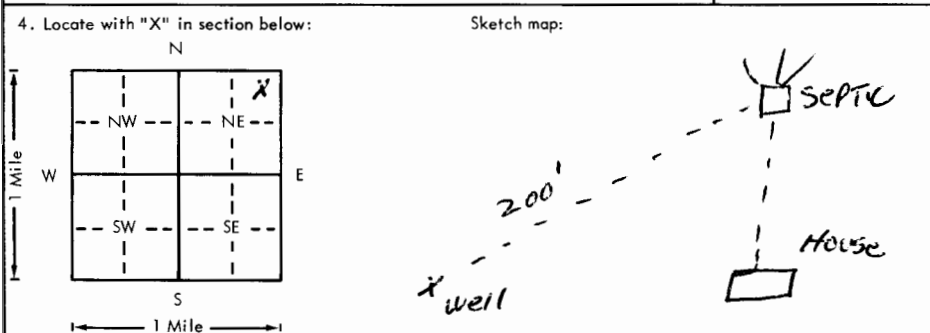

6. Bore hole dia. 10 in. Completion date 4-6-77  
Well depth 60 ft.  
7.  Cable tool  Rotary  Driven  Dug  
 Hollow rod  Jetted  Bored  Reverse rotary  
8. Use:  Domestic  Public supply  Industry  
 Irrigation  Air conditioning  Stock  
 Lawn  Oil field water  Other  
9. Casing: Material PVC Height: above or below  
Threaded  Welded  Surface 24 in.  
RMP  PVC 9L Weight 255 lbs./ft.  
Dia. 5 in. to 60 ft. depth Wall Thickness: inches or  
Dia. 5 in. to 60 ft. depth gage No. 374.25P

5. Type and color of material	From	To
<u>TOP SOIL</u>	<u>0</u>	<u>4</u>
<u>CLAY BROWN</u>	<u>4</u>	<u>35</u>
<u>GRAVEL</u>	<u>35</u>	<u>40</u>
<u>SHALE, GREY</u>	<u>40</u>	<u>60</u>
(Use a second sheet if needed)		

10. Screen: Manufacturer's name PUMPCO  
Type PVC Dia. 5  
Slot/gauge .020 Length 30  
Set between 30 ft. and 60 ft.  
Gravel pack?  Size range of material 1030x060  
11. Static water level: 30 ft. below land surface Date 4-6-77 mo./day/yr.  
12. Pumping level below land surfaces: AIR TEST  
\_\_\_\_ ft. after \_\_\_\_ hrs. pumping \_\_\_\_ g.p.m.  
\_\_\_\_ ft. after \_\_\_\_ hrs. pumping \_\_\_\_ g.p.m.  
Estimated maximum yield 7 g.p.m.  
13. Water sample submitted: \_\_\_\_ Yes  No Date \_\_\_\_ mo./day/yr.  
14. Well head completion: CAP  
\_\_\_\_ Pitless adapter 24 inches above grade  
15. Well grouted?   
With:  Neat cement  Bentonite  Concrete  
Depth: From 0 ft. to 20 ft.  
16. Nearest source of possible contamination: ft. 200 Direction NE Type SEPTIC  
Well disinfected upon completion?  Yes  No  
17. Pump:  Not installed  
Manufacturer's name \_\_\_\_\_  
Model number \_\_\_\_\_ HP \_\_\_\_\_ Volts \_\_\_\_\_  
Length of drop pipe \_\_\_\_\_ ft. capacity \_\_\_\_\_ g.p.m.  
Type:  
 Submersible  Turbine  
 Jet  Reciprocating  
 Centrifugal  Other

18. Elevation:  
Topography:  
 Hill  
 Slope  
 Upland  
 Valley

19. Remarks:  
OWNER WILL INSTAL SLAB

20. Water well contractor's certification:  
This well was drilled under my jurisdiction and this report is true to the best of my knowledge and belief.  
Business name STRAIDER DRUG CO INC. 1P2  
Address RT 1 HOLTON, KS  
Signed Dale Baker Date 4-7-77  
Authorized representative

T 9 S R 12 E/W NE 1/4 NE 1/4