


1 LOCATION OF WATER WELL: Fraction SW 1/4 SW 1/4 SW 1/4 Section Number 26 Township Number T 9 S Range Number R 12 EW  
 County: Pottawatomie  
 Distance and direction from nearest town or city street address of well if located within city? FROM ST. MARYS GO NORTH ON 63 S. 5 miles then east on Doyle Creek 1/2 mile then North 1/4 mile

2 WATER WELL OWNER: Mike Zemele  
 RR#, St. Address, Box #: 206 S. 7th Board of Agriculture, Division of Water Resources  
 City, State, ZIP Code: St. Marys, Ks. 66536 Application Number:

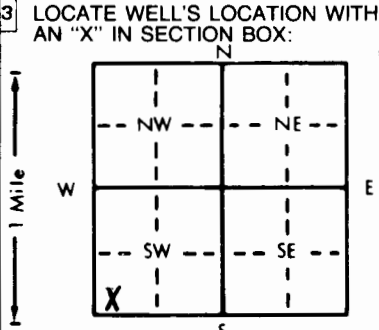

4 DEPTH OF COMPLETED WELL: 120 ft. ELEVATION:  
 Depth(s) Groundwater Encountered 1. 82 ft. 2. ft. 3. ft.  
 WELL'S STATIC WATER LEVEL: 70 ft. below land surface measured on mo/day/yr  
 Pump test data: Well water was ft. after hours pumping gpm  
 Est. Yield 5 gpm: Well water was ft. after hours pumping gpm  
 Bore Hole Diameter: 9 in. to 120 ft., and in. to ft.  
 WELL WATER TO BE USED AS:  
 1 Domestic  3 Feedlot  6 Oil field water supply  9 Dewatering  12 Other (Specify below)  
 2 Irrigation  4 Industrial  7 Lawn and garden only  10 Monitoring well  
 Was a chemical/bacteriological sample submitted to Department? Yes.....No.....; If yes, mo/day/yr sample was submitted  
 Water Well Disinfected?  Yes  No

5 TYPE OF BLANK CASING USED:  
 1 Steel  3 RMP (SR)  6 Asbestos-Cement  9 Other (specify below)  
 2 PVC  4 ABS  7 Fiberglass  
 Blank casing diameter: 5 in. to ft. Dia. in. to ft. Dia. in. to ft.  
 Casing height above land surface: 2ft in. weight Sch 40 lbs./ft. Wall thickness or gauge No.  
 TYPE OF SCREEN OR PERFORATION MATERIAL:  
 1 Steel  3 Stainless steel  5 Fiberglass  7 PVC  10 Asbestos-cement  
 2 Brass  4 Galvanized steel  6 Concrete tile  9 ABS  11 Other (specify)  
 SCREEN OR PERFORATION OPENINGS ARE:  
 1 Continuous slot  3 Mill slot 25/5000  5 Gauzed wrapped  8 Saw cut  11 None (open hole)  
 2 Louvered shutter  4 Key punched  6 Wire wrapped  9 Drilled holes  
 7 Torch cut  10 Other (specify)  
 SCREEN-PERFORATED INTERVALS: From 100 ft. to 120 ft. From ft. to ft.  
 GRAVEL PACK INTERVALS: From 25 ft. to 120 ft. From ft. to ft.

6 GROUT MATERIAL:  1 Neat cement  2 Cement grout  3 Bentonite  4 Other  
 Grout Intervals: From 0 ft. to 25 ft. From ft. to ft. From ft. to ft.  
 What is the nearest source of possible contamination:  
 1 Septic tank  4 Lateral lines NONE, CLOSE  7 Pit privy  
 2 Sewer lines  5 Cess pool  8 Sewage lagoon  12 Fertilizer storage  16 Other (specify below)  
 3 Watertight sewer lines  6 Seepage pit  9 Feedyard  13 Insecticide storage  
 Direction from well? How many feet?

FROM	TO	LITHOLOGIC LOG	FROM	TO	PLUGGING INTERVALS
0	1	Top Soil			
1	3	Brown Clay			
3	4	Limestone			
4	41	Yellow Shale			
41	50	Brown Shale			
50	70	Oily Gray Shale (Dark)			
70	76	<del>Dark</del> Limestone			
76	82	Gray Shale			
82	86	Limestone (water)			
86	102	Tan Shale			
102	112	Limestone			
112	120	Brown Shale			

7 CONTRACTOR'S OR LANDOWNER'S CERTIFICATION: This water well was  (1) constructed,  (2) reconstructed, or  (3) plugged under my jurisdiction and was completed on (mo/day/year) 7/15/91 and this record is true to the best of my knowledge and belief. Kansas Water Well Contractor's License No. 45191 This Water Well Record was completed on (mo/day/yr) 7/2/88 under the business name of Holdman Well Drilling by (signature) Wayne Cupps