


USE TYPEWRITER OR BALL POINT PEN-PRESS FIRMLY, PRINT CLEARLY.

WATER WELL RECORD
KSA 82a-1201-1215

Kansas Department of Health and Environment-Division of Environment
(Water well Contractors)
Topeka, Kansas 66620

1. Location of well: County POK Fraction NE 1/4 NE 1/4 SE 1/4 Section number 4 Township number T 9 S R 12 Range number E/W

2. Distance and direction from nearest town or city: 2S 2W 3. Owner of well: ROY SMITH
Street address of well location if in city: OF EMMETT R.R. or street:
City, state, zip code: ST. MARYS, KS.

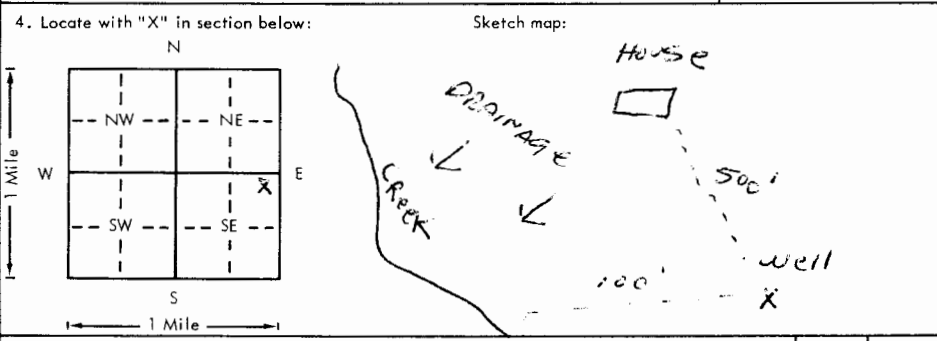

6. Bore hole dia. 1 1/2 in. Completion date _____
Well depth 85 ft. 3-29-76

7. Cable tool Rotary Driven Dug
 Hollow rod Jetted Bored Reverse rotary

8. Use: Domestic Public supply Industry
 Irrigation Air conditioning Stock
 Lawn Oil field water Other

9. Casing: Material PVC Height: (Above or below) _____
Threaded _____ Welded _____ Surface 24 in.
RMP _____ PVC GL Weight 2.55 lbs./ft.
Dia. 5 in. to 35 ft. depth Wall Thickness: inches or
Dia. _____ in. to _____ ft. depth Gage No. 258

5. Type and color of material	From	To
TOP SOIL	0	3
BROWN CLAY	3	14
GREY LIMESTONE	14	29
GREY SHALE	29	67
YELLOW LIME (SOFT)	67	72
GREY SHALE	72	75
GREY LIME	75	76
RED SHALE	76	85

10. Screen: Manufacturer's name PUMPCO
Type PVC Dia. 5"
Slot/gauze 060 Length 20'
Set between 65 ft. and 85 ft.
Gravel pack? Size range of material 24X48

11. Static water level: _____ mo./day/yr.
70 ft. below land surface Date 3-29-76

12. Pumping level below land surfaces: AIR TEST
_____ ft. after _____ hrs. pumping _____ g.p.m.
_____ ft. after _____ hrs. pumping _____ g.p.m.
Estimated maximum yield 15 AT 76' g.p.m.

13. Water sample submitted: _____ mo./day/yr.
 Yes No Date _____

14. Well head completion: CAPPED
 Pitless adapter 24 inches above grade

15. Well grouted?
With: Neat cement Bentonite Concrete
Depth: From 0 ft. to 10 ft.

16. Nearest source of possible contamination: _____
ft. 100 Direction W Type DRAINAGE
Well disinfected upon completion? Yes No

17. Pump: Not installed
Manufacturer's name _____
Model number _____ HP _____ Volts _____
Length of drop pipe _____ ft. capacity _____ g.p.m.
Type:
 Submersible Turbine
 Jet Reciprocating
 Centrifugal Other

18. Elevation: _____ 19. Remarks: OWNER WILL INSTALL SLAB

20. Water well contractor's certification: This well was drilled under my jurisdiction and this report is true to the best of my knowledge and belief.
STRADER DIECK CO INC 182
Business name License No. _____
Address: RT1 HOLTEN KS
Signed: Dale Johnson Date: 3-30-76
Authorized representative