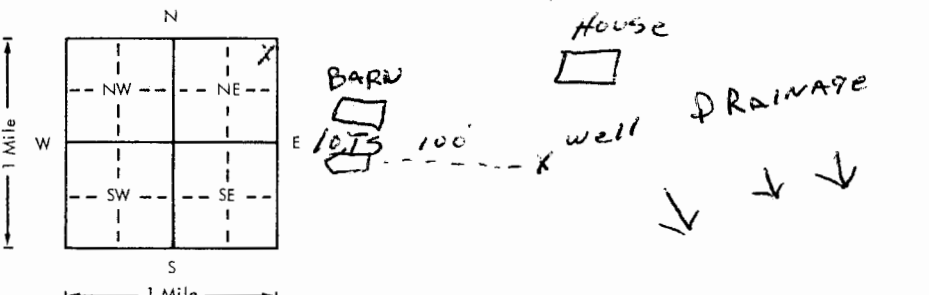


USE TYPEWRITER OR BALL POINT PEN—PRESS FIRMLY, PRINT CLEARLY.

WATER WELL RECORD
KSA 82a-1201-1215

Kansas Department of Health and Environment—Division of Environment
(Water well Contractors)
Topeka, Kansas 66620

1. Location of well:		County POTAWATOMIE	Fraction NE 1/4 NE 1/4 NE 1/4	Section number 4	Township number T 9 S R 12 E/W	Range number 12
2. Distance and direction from nearest town or city: .7 W Street address of well location if in city: off Emmett			3. Owner of well: CLARENCE REZAK R.R. or street: RR City, state, zip code: Emmett, KS. 66422			
4. Locate with "X" in section below: 			6. Bore hole dia. 10 in. Completion date _____ Well depth 100 ft. 2-20-76			
5. Type and color of material			7. Cable tool <input checked="" type="checkbox"/> Rotary <input type="checkbox"/> Driven <input type="checkbox"/> Dug <input type="checkbox"/> Hollow rod <input type="checkbox"/> Jetted <input type="checkbox"/> Bored <input type="checkbox"/> Reverse rotary			
			8. Use: <input checked="" type="checkbox"/> Domestic <input type="checkbox"/> Public supply <input type="checkbox"/> Industry <input type="checkbox"/> Irrigation <input type="checkbox"/> Air conditioning <input type="checkbox"/> Stock <input type="checkbox"/> Lawn <input type="checkbox"/> Oil field water <input type="checkbox"/> Other			
			9. Casing: Material PVC Height: Above or below Threaded _____ Welded _____ Surface 24 in. 2.8 RMP _____ PVC GL Weight 258 lbs./ft. Dia. 5 in. to 100 ft. depth Wall Thickness: inches or Dia. _____ in. to _____ ft. depth <input checked="" type="checkbox"/> gage No. 258			
			10. Screen: Manufacturer's name _____ PUMPCO Type PVC Dia. 5" <input checked="" type="checkbox"/> gauze .050 Length 20' Set between 90 ft. and 100 ft. _____ ft. and _____ ft. Gravel pack? <input checked="" type="checkbox"/> Size range of material 1/4 X 1/8			
			11. Static water level: _____ mo./day/yr. 85 ft. below land surface Date 2-20-76			
			12. Pumping level below land surfaces: AIR TEST _____ ft. after _____ hrs. pumping _____ g.p.m. _____ ft. after _____ hrs. pumping _____ g.p.m. Estimated maximum yield _____ g.p.m.			
			13. Water sample submitted: _____ mo./day/yr. Yes <input checked="" type="checkbox"/> No <input type="checkbox"/> Date _____			
			14. Well head completion: CAPPED <input type="checkbox"/> Pitless adapter 24 inches above grade			
			15. Well grouted? <input checked="" type="checkbox"/> With: <input checked="" type="checkbox"/> Neat cement <input type="checkbox"/> Bentonite <input type="checkbox"/> Concrete Depth: From 0 ft. to 12 ft.			
			16. Nearest source of possible contamination: ft. 100 Direction W Type LOTS Well disinfected upon completion? _____ Yes _____ No			
			17. Pump: <input checked="" type="checkbox"/> Not installed Manufacturer's name _____ Model number _____ HP _____ Volts _____ Length of drop pipe _____ ft. capacity _____ g.p.m. Type: <input type="checkbox"/> Submersible <input type="checkbox"/> Turbine <input type="checkbox"/> Jet <input type="checkbox"/> Reciprocating <input type="checkbox"/> Centrifugal <input type="checkbox"/> Other			
18. Elevation:			19. Remarks: OWN WILL INSTALL SLAB			
20. Water well contractor's certification: This well was drilled under my jurisdiction and this report is true to the best of my knowledge and belief. Stephen Dohy Co Inc 182 Business name _____ License No. _____ Address RT1 HOLTON, KS Signed W. Co. Arthur Date 2-22-76 Authorized representative						