

LOCATION OF WATER WELL: Fraction $\frac{1}{4}$ $\frac{1}{4}$ NW $\frac{1}{4}$ Section Number 15 Township Number T 9 R 12 Range Number 12


Distance and direction from nearest town or city street address of well if located within city? From Emmitt Go 2.5 miles south on Highway 63 & 40th East

WATER WELL OWNER: RAY Rodenbaugh
 RR#, St. Address, Box #: RR#1
 City, State, ZIP Code: ST MARYS KANSAS

Board of Agriculture, Division of Water Resources
 Application Number:

LOCATE WELL'S LOCATION WITH AN "X" IN SECTION BOX:

DEPTH OF COMPLETED WELL: 140 ft. ELEVATION:

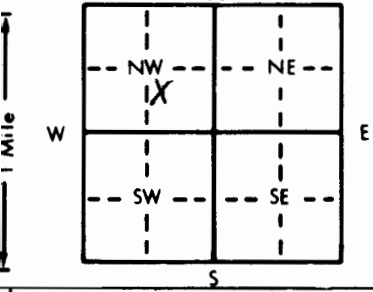

Depth(s) Groundwater Encountered 1. 116' ft. 2. ft. 3. ft.
 WELL'S STATIC WATER LEVEL 110' ft. below land surface measured on mo/day/yr
 Pump test data: Well water was ft. after hours pumping gpm
 Est. Yield 4 gpm: Well water was ft. after hours pumping gpm
 Bore Hole Diameter 8 in. to 140' ft., and in. to ft.
 WELL WATER TO BE USED AS:
 1 Domestic 3 Feedlot 6 Oil field water supply 9 Dewatering 12 Other (Specify below)
 2 Irrigation 4 Industrial 7 Lawn and garden only 10 Observation well
 Was a chemical/bacteriological sample submitted to Department? Yes No; If yes, mo/day/yr sample was submitted
 Water Well Disinfected? Yes No

TYPE OF BLANK CASING USED:
 1 Steel 3 RMP (SR) 5 Wrought iron 8 Concrete tile CASING JOINTS: Glued Clamped
 2 PVC 4 ABS 6 Asbestos-Cement 9 Other (specify below) Welded Screwed
 7 Fiberglass Threaded

Blank casing diameter 5 in. to 140' ft., Dia. in. to ft., Dia. in. to ft.
 Casing height above land surface 3' in., weight lbs./ft. Wall thickness or gauge No.

TYPE OF SCREEN OR PERFORATION MATERIAL:
 1 Steel 3 Stainless steel 5 Fiberglass 8 RMP (SR) 10 Asbestos-cement
 2 Brass 4 Galvanized steel 6 Concrete tile 9 ABS 11 Other (specify)
 12 None used (open hole)

SCREEN OR PERFORATION OPENINGS ARE: 3 Mill slot 5 Gauzed wrapped 8 Saw cut 11 None (open hole)
 1 Continuous slot 2 Louvered shutter 4 Key punched 6 Wire wrapped 9 Drilled holes 10 Other (specify)

SCREEN-PERFORATED INTERVALS: From 120 ft. to 140 ft., From ft. to ft.
 GRAVEL PACK INTERVALS: From 15 ft. to 140 ft., From ft. to ft.

GROUT MATERIAL: 1 Neat cement 2 Cement grout 3 Bentonite 4 Other
 Grout intervals: From 5 ft. to 15 ft., From ft. to ft., From ft. to ft.

What is the nearest source of possible contamination:
 1 Septic tank 4 Lateral lines 7 Pit privy 10 Livestock pens 14 Abandoned water well
 2 Sewer lines 5 Cess pool 8 Sewage lagoon 11 Fuel storage 15 Oil well/Gas well
 3 Watertight sewer lines 6 Seepage pit 9 Feedyard 12 Fertilizer storage 16 Other (specify below)
 13 Insecticide storage

Direction from well? EAST How many feet? 140'

FROM	TO	LITHOLOGIC LOG	FROM	TO	LITHOLOGIC LOG
0	8	Brown Clay			
8	25	SOFT Rock			
25	33	Green Clay			
33	48	Brown Clay			
48	56	Red Clay			
56	67	Rock			
67	77	Yellow Clay			
77	85	Rock			
85	90	Yellow Clay			
90	93	Rock			
93	116	Green Clay			
116	125	Rock			
125	140	Grey Shell			

CONTRACTOR'S OR LANDOWNER'S CERTIFICATION: This water well was (1) constructed (2) reconstructed, or (3) plugged under my jurisdiction and was completed on (mo/day/year) 2/6/86 and this record is true to the best of my knowledge and belief. Kansas Water Well Contractor's License No. 451 This Water Well Record was completed on (mo/day/yr) 2/9/86 under the business name of Haldeman Well Drilling by (signature) Craig Haldeman

INSTRUCTIONS: Use typewriter or ball point pen, PLEASE PRESS FIRMLY and PRINT clearly. Please fill in blanks, underlining or circle the correct answers. Send top three copies to Kansas Department of Health and Environment, Division of Environment, Environmental Geology Section, Topeka, KS 66620. Send one to WATER WELL OWNER and retain one for your records.