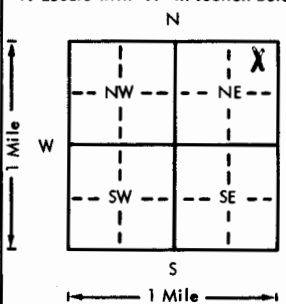


USE TYPEWRITER OR BALL POINT PEN-PRESS FIRMLY, PRINT CLEARLY.

WATER WELL RECORD  
KSA 82a-1201-1215

Kansas Department of Health and Environment-Division of Environment  
(Water well Contractors)  
Topeka, Kansas 66620

1. Location of well:	County <b>POTTAWATOMIE</b>	Fraction <b>NE 1/4 NE 1/4 NE 1/4</b>	Section number <b>18</b>	Township number <b>T 9 S R 12 E/W</b>	Range number																					
2. Distance and direction from nearest town or city: <b>3 S 2.8 W</b>			3. Owner of well: <b>RICHARD CARLSON</b> R <del>X</del> or street: <b>521 BURTRAND</b> City, state, zip code: <b>ST. MARYS, KS 66536</b>																							
4. Locate with "X" in section below: Sketch map: 			6. Bore hole dia. <b>8</b> in. Completion date <b>5-11-76</b> Well depth <b>50</b> ft.																							
5. Type and color of material			7. <input type="checkbox"/> Cable tool <input checked="" type="checkbox"/> Rotary <input type="checkbox"/> Driven <input type="checkbox"/> Dug <input type="checkbox"/> Hollow rod <input type="checkbox"/> Jetted <input type="checkbox"/> Bored <input type="checkbox"/> Reverse rotary																							
			8. Use: <input checked="" type="checkbox"/> Domestic <input type="checkbox"/> Public supply <input type="checkbox"/> Industry <input type="checkbox"/> Irrigation <input type="checkbox"/> Air conditioning <input type="checkbox"/> Stock <input type="checkbox"/> Lawn <input type="checkbox"/> Oil field water <input type="checkbox"/> Other																							
<table border="1" style="width:100%; border-collapse: collapse;"> <thead> <tr> <th style="width:50%;"></th> <th style="width:10%;">From</th> <th style="width:10%;">To</th> </tr> </thead> <tbody> <tr> <td>TOP SOIL</td> <td>0</td> <td>4</td> </tr> <tr> <td>BROWN CLAY</td> <td>4</td> <td>10</td> </tr> <tr> <td>* Grey shale</td> <td>10</td> <td>18</td> </tr> <tr> <td>- yellow Lime</td> <td>18</td> <td>21</td> </tr> <tr> <td>Red shale</td> <td>21</td> <td>42</td> </tr> <tr> <td>Blue shale</td> <td>42</td> <td>50</td> </tr> </tbody> </table>				From	To	TOP SOIL	0	4	BROWN CLAY	4	10	* Grey shale	10	18	- yellow Lime	18	21	Red shale	21	42	Blue shale	42	50	9. Casing: Material <b>PVC</b> Height: <b>above</b> or below Threaded <input type="checkbox"/> Welded <input type="checkbox"/> Surface <b>24</b> in. RMP <input type="checkbox"/> PVC <b>9L</b> Weight <b>2.88</b> lbs./ft. Dia. <b>5</b> in. to <b>50</b> ft. depth; Well Thickness: inches or Dia. <input type="checkbox"/> in. to <input type="checkbox"/> ft. depth; page No. <b>258</b>		
(Use a second sheet if needed)			10. Screen: Manufacturer's name <b>PUMPCO</b> Type <b>PVC</b> Dia. <b>5</b> <input checked="" type="checkbox"/> gauze <b>.060</b> Length <b>20</b> Set between <b>15</b> ft. and <b>35</b> ft. ft. and <input type="checkbox"/> ft. Gravel pack? <input checked="" type="checkbox"/> Size range of material <b>1/4 X 1/8</b>																							
			11. Static water level: <input type="checkbox"/> mo./day/yr. <b>10</b> ft. below land surface Date <b>5-11-76</b>																							
18. Elevation:  Topography: <input type="checkbox"/> Hill <input checked="" type="checkbox"/> Slope <input type="checkbox"/> Upland <input type="checkbox"/> Valley			12. Pumping level below land surfaces: <b>AIR TEST</b> <input type="checkbox"/> ft. after <input type="checkbox"/> hrs. pumping <input type="checkbox"/> g.p.m. <input type="checkbox"/> ft. after <input type="checkbox"/> hrs. pumping <input type="checkbox"/> g.p.m. Estimated maximum yield <b>6</b> g.p.m.																							
			13. Water sample submitted: <input type="checkbox"/> mo./day/yr. Yes <input checked="" type="checkbox"/> No Date																							
19. Remarks: <b>OWNER WILL INSTAL SLAB</b>			14. Well head completion: <b>CAPPED</b> <input type="checkbox"/> Pitless adapter <b>24</b> inches above grade																							
			15. Well grouted? <input checked="" type="checkbox"/> With: <input checked="" type="checkbox"/> Neat cement <input type="checkbox"/> Bentonite <input type="checkbox"/> Concrete Depth: From <b>0</b> ft. to <b>10</b> ft.																							
20. Water well contractor's certification: This well was drilled under my jurisdiction and this report is true to the best of my knowledge and belief. <b>STADER Dalg Co Inc 183</b> Business name License No. Address <b>RT 1 Holton, KS</b> Signed <b>Dale Robinson</b> Date <b>5-14-76</b> Authorized representative			16. Nearest source of possible contamination: ft. <b>200</b> Direction <b>NW</b> Type <b>SEPTIC</b> Well disinfected upon completion? <input checked="" type="checkbox"/> Yes <input type="checkbox"/> No																							
			17. Pump: <input checked="" type="checkbox"/> Not installed Manufacturer's name _____ HP _____ Volts _____ Length of drop pipe _____ ft. capacity _____ g.p.m. Type: <input type="checkbox"/> Submersible <input type="checkbox"/> Turbine <input type="checkbox"/> Jet <input type="checkbox"/> Reciprocating <input type="checkbox"/> Centrifugal <input type="checkbox"/> Other																							

9-12-76  
 R  
 18  
 NE NE NE  
 1/4 1/4 1/4

Forward the white, blue and pink copies to the Department of Health and Environment

Form WWC-5