


1 LOCATION OF WATER WELL: Fraction SW 1/4 SW 1/4 NE 1/4 Section Number 26 Township Number T 9 S Range Number R 12 E  
 County: Pottawatomie

Distance and direction from nearest town or city street address of well if located within city?  
1 1/2 mi. E, 3 1/4 mi. N. of St. Marys, KS

2 WATER WELL OWNER: Clyde Aubert  
 RR#, St. Address, Box #: St. Marys, KS 66536  
 City, State, ZIP Code: St. Marys, KS 66536  
 Board of Agriculture, Division of Water Resources  
 Application Number:

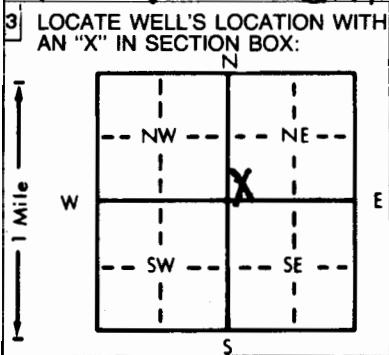

4 DEPTH OF COMPLETED WELL: 51 ft. ELEVATION: ..... ft.  
 Depth(s) Groundwater Encountered 1. 23 ft. 2. .... ft. 3. .... ft.  
 WELL'S STATIC WATER LEVEL 13 ft. below land surface measured on 6-18-81  
 Pump test data: Well water was NC ft. after 3 1/2 hours pumping 15 gpm  
 Est. Yield 15 gpm; Well water was ..... ft. after ..... hours pumping ..... gpm  
 Bore Hole Diameter: 8 1/2 in. to 51 ft., and ..... in. to ..... ft.  
 WELL WATER TO BE USED AS:  
 1 Domestic 3 Feedlot 6 Oil field water supply 9 Dewatering 12 Other (Specify below)  
 2 Irrigation 4 Industrial 7 Lawn and garden only 10 Observation well  
 Was a chemical/bacteriological sample submitted to Department? Yes.....No X.....; If yes, mo/day/yr sample was submitted  
 Water Well Disinfected? Yes X No

5 TYPE OF BLANK CASING USED:  
 1 Steel 3 RMP (SR) 5 Wrought iron 8 Concrete tile CASING JOINTS: Glued X Clamped .....  
 2 PVC 4 ABS 6 Asbestos-Cement 9 Other (specify below) Welded .....  
 7 Fiberglass Threaded.....  
 Blank casing diameter 5 in. to ~~41~~ ft., Dia ..... in. to ..... ft., Dia ..... in. to ..... ft.  
 Casing height above land surface 18 in., weight .214 lbs./ft. Wall thickness or gauge No. ....  
 TYPE OF SCREEN OR PERFORATION MATERIAL:  
 1 Steel 3 Stainless steel 5 Fiberglass 8 RMP (SR) 10 Asbestos-cement  
 2 Brass 4 Galvanized steel 6 Concrete tile 9 ABS 12 None used (open hole)  
 SCREEN OR PERFORATION OPENINGS ARE:  
 1 Continuous slot 3 Mill slot 5 Gauzed wrapped 8 Saw cut 11 None (open hole)  
 2 Louvered shutter 4 Key punched 6 Wire wrapped 9 Drilled holes  
 7 Torch cut 10 Other (specify) .....  
 SCREEN-PERFORATED INTERVALS: From 41 ft. to 51 ft., From ..... ft. to ..... ft.  
 From ..... ft. to ..... ft., From ..... ft. to ..... ft.  
 GRAVEL PACK INTERVALS: From 13 ft. to 51 ft., From ..... ft. to ..... ft.  
 From ..... ft. to ..... ft., From ..... ft. to ..... ft.

6 GROUT MATERIAL: 1 Neat cement 2 Cement grout 3 Bentonite 4 Other .....  
 Grout Intervals: From 3 ft. to 13 ft., From ..... ft. to ..... ft., From ..... ft. to ..... ft.  
 What is the nearest source of possible contamination:  
 1 Septic tank 4 Lateral lines 7 Pit privy 10 Livestock pens 14 Abandoned water well  
 2 Sewer lines 5 Cess pool 8 Sewage lagoon 11 Fuel storage 15 Oil well/Gas well  
 3 Watertight sewer lines 6 Seepage pit 9 Feedyard 12 Fertilizer storage 16 Other (specify below)  
 13 Insecticide storage  
 Direction from well? ~~500~~ West How many feet? 500

FROM	TO	LITHOLOGIC LOG	FROM	TO	LITHOLOGIC LOG
0	23	Silt			
23	27	Gravel			
27	30	Limestone			
30	47	Shale			
47	50	Gray Clay			

7 CONTRACTOR'S OR LANDOWNER'S CERTIFICATION: This water well was (1) constructed, (2) reconstructed, or (3) plugged under my jurisdiction and was completed on (mo/day/year) 6-14-81 and this record is true to the best of my knowledge and belief. Kansas Water Well Contractor's License No. 405 This Water Well Record was completed on (mo/day/yr) 6-22-81 under the business name of Haworth Drilling by (signature) Walter C Haworth  
 INSTRUCTIONS: Use typewriter or ball point pen, PLEASE PRESS FIRMLY and PRINT clearly. Please fill in blanks, underline or circle the correct answers. Send top three copies to Kansas Department of Health and Environment, Division of Environment, Environmental Geology Section, Topeka, KS 66620. Send one to WATER WELL OWNER and retain one for your records.