


USE TYPEWRITER OR BALL POINT PEN-PRESS FIRMLY, PRINT CLEARLY.

WATER WELL RECORD
KSA 82a-1201-1215

Kansas Department of Health and Environment-Division of Environment
(Water well Contractors)
Topeka, Kansas 66620

1. Location of well: County POTTAWATOMIE Fraction SE 1/4 SE 1/4 SE 1/4 Section number 33 Township number T 9 S R 12 E/W

2. Distance and direction from nearest town or city: .7 NORTH 3. Owner of well: CLARENCE REZAK
Street address of well location if in city: OF Emmett R.R. or street:
City, state, zip code: Emmett, KS. 66422

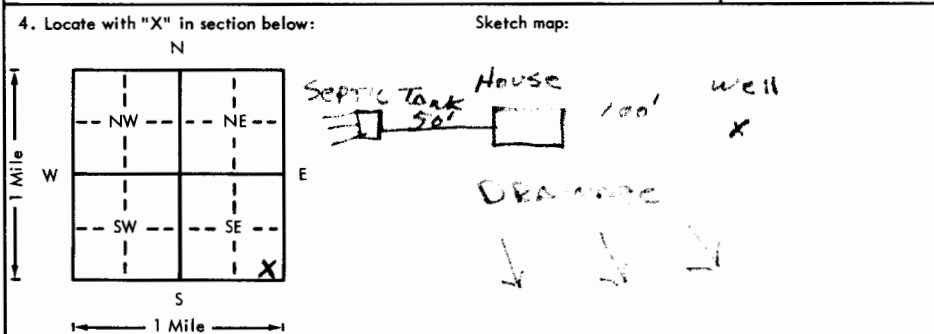

6. Bore hole dia. 10 in. Completion date 2-20-76
Well depth 90 ft.

7. Cable tool Rotary Driven Dug
 Hollow rod Jetted Bored Reverse rotary

8. Use: Domestic Public supply Industry
 Irrigation Air conditioning Stock
 Lawn Oil field water Other

9. Casing: Material PVC Height: Above or below
Threaded Welded Surface 24 in.
RMP PVC GL Weight 2.58 lbs./ft.
Dia. 5 in. to 90 ft. depth Wall Thickness: inches or
Dia. 5 in. to 90 ft. depth gage No.

| 5. Type and color of material | From | To |
|--------------------------------|------|----|
| TOP SOIL | 0 | 3 |
| BROWN CLAY | 3 | 10 |
| BROWN LIMESTONE | 10 | 15 |
| Red shale | 15 | 40 |
| grey shale | 40 | 75 |
| yellow Limestone (49 ft) | 75 | 80 |
| Blue shale | 80 | 90 |
| (Use a second sheet if needed) | | |

10. Screen: Manufacturer's name RUMPCO
Type PVC Dia. 5"
Slot gauze .080 Length 16'
Set between 74 ft. and 90 ft.
Gravel pack? Size range of material 1/4 X 1/8

11. Static water level: 70 ft. below land surface Date 2-20-76 mo./day/yr.

12. Pumping level below land surfaces: AIR TEST
 ft. after hrs. pumping g.p.m.
 ft. after hrs. pumping g.p.m.
Estimated maximum yield 4 g.p.m.

13. Water sample submitted: mo./day/yr.
 Yes No Date

14. Well head completion: CAPPED
 Pitless adapter 24 inches above grade

15. Well grouted?
With: Neat cement Bentonite Concrete
Depth: From 0 ft. to 10 ft.

16. Nearest source of possible contamination:
ft. 150 Direction W Type SEPTIC
Well disinfected upon completion? Yes No

17. Pump: Not installed
Manufacturer's name
Model number HP Volts
Length of drop pipe ft. capacity g.p.m.
Type:
 Submersible Turbine
 Jet Reciprocating
 Centrifugal Other

18. Elevation:

Topography:
 Hill
 Slope
 Upland
 Valley

19. Remarks: OWNER WILL INSTALL SLAB

20. Water well contractor's certification:
This well was drilled under my jurisdiction and this report is true to the best of my knowledge and belief.
SINADER DAUG CO. INC. 182
Business name License No.
Address RT 1 HOLLON, KS
Signed Dale Robinson Date 2-22-76
Authorized representative

T 9 S R 12 E/W Sec 33 SE 1/4 SE 1/4 SE 1/4