


1 LOCATION OF WATER WELL: County: POTT Fraction: N 1/4 SW 1/4 NE 1/4 Section Number: 34 Township Number: T 9 S Range Number: R 12 E/W
 Distance and direction from nearest town or city street address of well if located within city? From SAINT MARYS GO 2 miles North on 63 Highway To Dole Creek Rd + Go 1/4 mile EAST Then South 3/8 mile

2 WATER WELL OWNER: Dennis Sumner
 RR#, St. Address, Box #: 306 Dupink Board of Agriculture, Division of Water Resources
 City, State, ZIP Code: SAINT MARYS, KS 66536 Application Number:

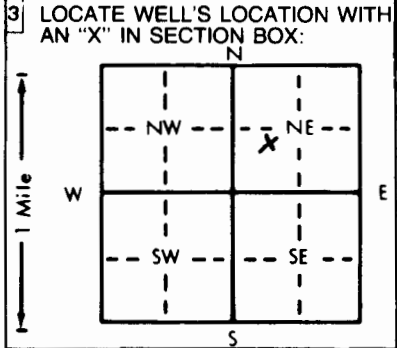

4 DEPTH OF COMPLETED WELL: 120 ft. ELEVATION:
 Depth(s) Groundwater Encountered 1. 94 ft. 2. ft. 3. ft.
 WELL'S STATIC WATER LEVEL: 80 ft. below land surface measured on mo/day/yr
 Pump test data: Well water was ft. after hours pumping gpm
 Est. Yield: 20 gpm; Well water was ft. after hours pumping gpm
 Bore Hole Diameter: 9 in. to 120 ft., and in. to ft.
 WELL WATER TO BE USED AS:
 1 Domestic 3 Feedlot 6 Oil field water supply 9 Dewatering 11 Injection well
 2 Irrigation 4 Industrial 7 Lawn and garden only 10 Monitoring well 12 Other (Specify below)
 Was a chemical/bacteriological sample submitted to Department? Yes.....No.....; If yes, mo/day/yr sample was submitted
 Water Well Disinfected? Yes No

5 TYPE OF BLANK CASING USED:
 1 Steel 3 RMP (SR) 5 Wrought iron 8 Concrete tile CASING JOINTS: Glued Clamped Welded Threaded
 2 PVC 4 ABS 6 Asbestos-Cement 9 Other (specify below)
 1 Steel 3 Stainless steel 5 Fiberglass 8 RMP (SR) 11 Other (specify)
 2 Brass 4 Galvanized steel 6 Concrete tile 9 ABS 12 None used (open hole)
 Blank casing diameter: 5 in. to 100 ft., Dia. in. to ft., Dia. in. to ft.
 Casing height above land surface: 2' in., weight: 160 lb lbs./ft. Wall thickness or gauge No.
 TYPE OF SCREEN OR PERFORATION MATERIAL:
 1 Steel 3 Stainless steel 5 Fiberglass 7 PVC 10 Asbestos-cement
 2 Brass 4 Galvanized steel 6 Concrete tile 9 ABS 12 None used (open hole)
 SCREEN OR PERFORATION OPENINGS ARE:
 1 Continuous slot 3 Mill slot 31,000's 5 Gauzed wrapped 8 Saw cut 11 None (open hole)
 2 Louvered shutter 4 Key punched 6 Wire wrapped 9 Drilled holes
 7 Torch cut 10 Other (specify)
 SCREEN-PERFORATED INTERVALS: From: 100 ft. to 120' ft., From ft. to ft.
 GRAVEL PACK INTERVALS: From: 25 ft. to 120' ft., From ft. to ft.

6 GROUT MATERIAL: 1 Neat cement 2 Cement grout 3 Bentonite 4 Other
 Grout Intervals: From: 0 ft. to 25 ft., From ft. to ENVIRON ft. to ft.
 What is the nearest source of possible contamination: None Close
 1 Septic tank 4 Lateral lines 7 Pit privy 10 Livestock pens 14 Abandoned water well
 2 Sewer lines 5 Cess pool 8 Sewage lagoon 11 Fuel storage 15 Oil well/Gas well
 3 Watertight sewer lines 6 Seepage pit 9 Feedyard 12 Fertilizer storage 16 Other (specify below)
 13 Insecticide storage
 Direction from well? How many feet?

FROM	TO	LITHOLOGIC LOG	FROM	TO	PLUGGING INTERVALS
0	1/2	Top Soil	114	116	Limestone
1/2	5'	Limestone	116	120	Grey Shale
5	7	Yellow shale			
7	11	Limestone			
11	23	Tan shale			
23	34	Brown shale			
34	35	Limestone			
35	55	Brown shale			
55	59	Limestone			
59	65	Yellow shale			
65	75	Grey shale			
75	77	Limestone			
77	94	Grey shale			
94	99	Limestone (Water)			
99	114	Grey shale			

7 CONTRACTOR'S OR LANDOWNER'S CERTIFICATION: This water well was (1) constructed, (2) reconstructed, or (3) plugged under my jurisdiction and was completed on (mo/day/year) 4/19/91 and this record is true to the best of my knowledge and belief. Kansas Water Well Contractor's License No. 451 This Water Well Record was completed on (mo/day/yr) 4/19/91 under the business name of Holdeman Well Drilling by (signature) Craig CWD/PI