


1 LOCATION OF WATER WELL: Fraction NE 1/4 SE 1/4 NE 1/4 Section Number 34 Township Number T 9 S Range Number R 12 E
 County: Pott

Distance and direction from nearest town or city street address of well if located within city? From Saint Marys 60 2 Miles North on 63 to Doyle Creek + 60 1/2 mile East + 3/4 South

2 WATER WELL OWNER: Lee Thomas Const.
 RR#, St. Address, Box #: 5975 Riley Creek
 City, State, ZIP Code: Saint Marys, KS 66536
 Board of Agriculture, Division of Water Resources
 Application Number:

3 LOCATE WELL'S LOCATION WITH AN "X" IN SECTION BOX:

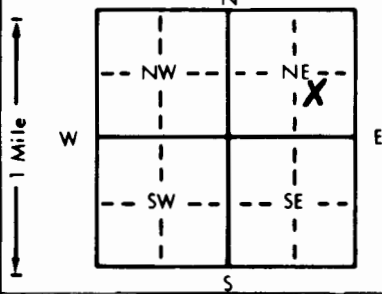

4 DEPTH OF COMPLETED WELL: 120 ft. ELEVATION:

Depth(s) Groundwater Encountered 1. 85 ft. 2. ft. 3. ft.

WELL'S STATIC WATER LEVEL 68 ft. below land surface measured on mo/day/yr

Pump test data: Well water was ft. after hours pumping gpm

Est. Yield 2.0 gpm: Well water was ft. after hours pumping gpm

Bore Hole Diameter 9 in. to 120 ft., and in. to ft.

WELL WATER TO BE USED AS: 5 Public water supply 8 Air conditioning 11 Injection well

1 Domestic 3 Feedlot 6 Oil field water supply 9 Dewatering 12 Other (Specify below)

2 Irrigation 4 Industrial 7 Lawn and garden only 10 Monitoring well

Was a chemical/bacteriological sample submitted to Department? Yes No; If yes, mo/day/yr sample was submitted

Water Well Disinfected Yes No

5 TYPE OF BLANK CASING USED: 5 Wrought iron 8 Concrete tile CASING JOINTS: Glued Clamped

1 Steel 3 RMP (SR) 6 Asbestos-Cement 9 Other (specify below) Welded

2 PVC 4 ABS 7 Fiberglass Threaded

Blank casing diameter 5 in. to 100 ft. Dia. in. to ft. Dia. in. to ft.

Casing height above land surface 2 in. weight 50# 40 lbs./ft. Wall thickness or gauge No.

TYPE OF SCREEN OR PERFORATION MATERIAL: 7 PVC 10 Asbestos-cement

1 Steel 3 Stainless steel 5 Fiberglass 8 RMP (SR) 11 Other (specify)

2 Brass 4 Galvanized steel 6 Concrete tile 9 ABS 12 None used (open hole)

SCREEN OR PERFORATION OPENINGS ARE: 3 Mill slot 3/1000 5 Gauzed wrapped 8 Saw cut 11 None (open hole)

1 Continuous slot 4 Key punched 6 Wire wrapped 9 Drilled holes

2 Louvered shutter 7 Torch cut 10 Other (specify)

SCREEN-PERFORATED INTERVALS: From 100 ft. to 120 ft. From ft. to ft.

GRAVEL PACK INTERVALS: From 25 ft. to 120 ft. From ft. to ft.

6 GROUT MATERIAL: 1 Neat cement 2 Cement grout 3 Bentonite 4 Other

Grout Intervals: From 0 ft. to 25 ft. From ft. to ft. From ft. to ft.

What is the nearest source of possible contamination: None Close

1 Septic tank 4 Lateral lines 7 Pit privy 10 Livestock pens 14 Abandoned water well

2 Sewer lines 5 Cess pool 8 Sewage lagoon 11 Fuel storage 15 Oil well/Gas well

3 Watertight sewer lines 6 Seepage pit 9 Feedyard 12 Fertilizer storage 16 Other (specify below)

13 Insecticide storage

Direction from well? How many feet?

FROM	TO	LITHOLOGIC LOG	FROM	TO	PLUGGING INTERVALS
0	2	Top Soil	115	116	Limestone
2	10	Greenish shale	116	120	Grey shale
10	15	Limestone			
15	21	Brown shale			
21	22	Limestone			
22	39	Greenish shale			
39	41	Limestone			
41	53	Brown shale			
53	66	Grey shale			
66	73	Limestone			
73	85	Brown shale			
85	93	Limestone (Water)			
93	101	Dark Grey shale			
101	111	Limestone			
111	115	Grey shale			

7 CONTRACTOR'S OR LANDOWNER'S CERTIFICATION: This water well was (1) constructed, (2) reconstructed, or (3) plugged under my jurisdiction and was completed on (mo/day/year) 4/27/92 and this record is true to the best of my knowledge and belief. Kansas

Water Well Contractor's License No. 451 This Water Well Record was completed on (mo/day/yr) 4/27/92

under the business name of Hal Leman Well Drilling by (signature) Craig