


1 LOCATION OF WATER WELL: County: POTT Fraction: SW 1/4 NW 1/4 NE 1/4 Section Number: 35 Township Number: T 9 S Range Number: R 12 E

Distance and direction from nearest town or city street address of well if located within city? From St Marys 60 2.5 miles North on 63 Highway + 3/4 mile on Doyle Court + 1/4 South

2 WATER WELL OWNER: Jerry Gayner  
 RR#, St. Address, Box #: 100  
 City, State, ZIP Code: St. Marys Kansas 66536  
 Board of Agriculture, Division of Water Resources  
 Application Number:

3 LOCATE WELL'S LOCATION WITH AN "X" IN SECTION BOX:

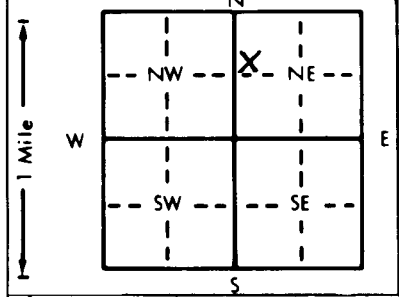

4 DEPTH OF COMPLETED WELL: 100' ft. ELEVATION:  
 Depth(s) Groundwater Encountered 1. 7.3 ft. 2. ft. 3. ft.  
 WELL'S STATIC WATER LEVEL: 60 ft. below land surface measured on mo/day/yr  
 Pump test data: Well water was ft. after hours pumping gpm  
 Est. Yield: 1.2 gpm: Well water was ft. after hours pumping gpm  
 Bore Hole Diameter: 9 in. to 100 ft., and in. to ft.  
 WELL WATER TO BE USED AS:  
 1 Domestic  3 Feedlot  6 Oil field water supply  9 Dewatering  12 Other (Specify below)  
 2 Irrigation  4 Industrial  7 Lawn and garden only  10 Monitoring well  
 Was a chemical/bacteriological sample submitted to Department? Yes No; If yes, mo/day/yr sample was submitted  
 Water Well Disinfected?  Yes No

5 TYPE OF BLANK CASING USED:  
 1 Steel  3 RMP (SR)  6 Asbestos-Cement  9 Other (specify below)  
 2 PVC  4 ABS  7 Fiberglass  8 Concrete tile  10 Asbestos-cement  
 CASING JOINTS:  Glued  Clamped  Welded  Threaded

Blank casing diameter: 5 in. to 80 ft., Dia. in. to ft., Dia. in. to ft.  
 Casing height above land surface: 2 in., weight: 56.40 lbs./ft. Wall thickness or gauge No.

TYPE OF SCREEN OR PERFORATION MATERIAL:  
 1 Steel  3 Stainless steel  5 Fiberglass  7 PVC  10 Asbestos-cement  
 2 Brass  4 Galvanized steel  6 Concrete tile  8 RMP (SR)  11 Other (specify)  
 12 None used (open hole)

SCREEN OR PERFORATION OPENINGS ARE:  
 1 Continuous slot  3 Mill slot 25/1000's  5 Gauzed wrapped  8 Saw cut  11 None (open hole)  
 2 Louvered shutter  4 Key punched  6 Wire wrapped  9 Drilled holes  
 7 Torch cut  10 Other (specify)

SCREEN-PERFORATED INTERVALS: From 80 ft. to 100 ft., From ft. to ft., From ft. to ft.  
 GRAVEL PACK INTERVALS: From 25 ft. to 100 ft., From ft. to ft., From ft. to ft.

6 GROUT MATERIAL:  1 Neat cement  2 Cement grout  3 Bentonite  4 Other  
 Grout Intervals: From 0 ft. to 25 ft., From ft. to ft., From ft. to ft.

What is the nearest source of possible contamination: None Close  
 1 Septic tank  4 Lateral lines  7 Pit privy  10 Livestock pens  14 Abandoned water well  
 2 Sewer lines  5 Cess pool  8 Sewage lagoon  11 Fuel storage  15 Oil well/Gas well  
 3 Watertight sewer lines  6 Seepage pit  9 Feedyard  12 Fertilizer storage  16 Other (specify below)  
 13 Insecticide storage

Direction from well? How many feet?

FROM	TO	LITHOLOGIC LOG	FROM	TO	PLUGGING INTERVALS
0	1	Top Soil			
1	26	Brown shale			
26	28	Limestone			
28	48	Tan shale			
48	73	Grey shale			
73	85	Limestone (water)			
85	100	Greenish shale			

7 CONTRACTOR'S OR LANDOWNER'S CERTIFICATION: This water well was  (1) constructed,  (2) reconstructed, or  (3) plugged under my jurisdiction and was completed on (mo/day/year) 5/10/94 and this record is true to the best of my knowledge and belief. Kansas Water Well Contractor's License No. 451 This Water Well Record was completed on (mo/day/yr) 5/22/94 under the business name of Holdeman Well Drilling by (signature) Craig H. Holdeman