


1 LOCATION OF WATER WELL: County: POT Fraction: NE 1/4 SE 1/4 SW 1/4 Section Number: 29 Township Number: T 9 S Range Number: R 12 E

Distance and direction from nearest town or city street address of well if located within city? From ST Marys Go 2 miles North on 63 Highway to Dayle Creek Rd + Go 2 miles West + 1/4 North on Riley Creek Rd.

2 WATER WELL OWNER: Brad Shelly
 RR#, St. Address, Box #: 5850 Riley Creek Rd. Board of Agriculture, Division of Water Resources
 City, State, ZIP Code: ST. Marys, MS 66536 Application Number:

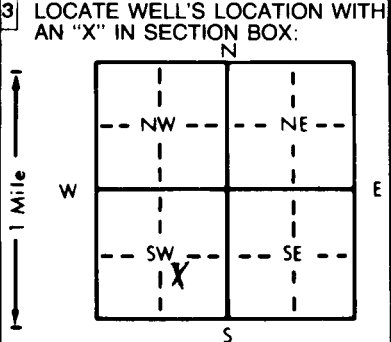

4 DEPTH OF COMPLETED WELL: 140 ft. ELEVATION: _____ ft.
 Depth(s) Groundwater Encountered 1. 108 ft. 2. _____ ft. 3. _____ ft.
 WELL'S STATIC WATER LEVEL: 105 ft. below land surface measured on mo/day/yr
 Pump test data: Well water was _____ ft. after _____ hours pumping _____ gpm
 Est. Yield 3.5 gpm: Well water was _____ ft. after _____ hours pumping _____ gpm
 Bore Hole Diameter: 9 in. to 140 in. to _____ in. to _____ ft.
 WELL WATER TO BE USED AS:
 1 Domestic 3 Feedlot 6 Oil field water supply 8 Air conditioning 11 Injection well
 2 Irrigation 4 Industrial 7 Lawn and garden only 9 Dewatering 10 Monitoring well
 Was a chemical/bacteriological sample submitted to Department? Yes _____ No _____; If yes, mo/day/yr sample was submitted _____
 Water Well Disinfected? Yes No

5 TYPE OF BLANK CASING USED:
 1 Steel 3 RMP (SR) 5 Wrought iron 8 Concrete tile CASING JOINTS: Glued Clamped
 2 PVC 4 ABS 6 Asbestos-Cement 9 Other (specify below) Welded
 7 Fiberglass Threaded
 Blank casing diameter: 5 in. to 120 in. Dia. _____ in. to _____ ft. Dia. _____ in. to _____ ft.
 Casing height above land surface: 2 in., weight: 8440 lbs./ft. Wall thickness or gauge No. _____
 TYPE OF SCREEN OR PERFORATION MATERIAL:
 1 Steel 3 Stainless steel 5 Fiberglass 8 RMP (SR) 10 Asbestos-cement
 2 Brass 4 Galvanized steel 6 Concrete tile 9 ABS 11 Other (specify) _____
 12 None used (open hole)
 SCREEN OR PERFORATION OPENINGS ARE:
 1 Continuous slot 3 Mill slot 25/100s 5 Gauzed wrapped 8 Saw cut 11 None (open hole)
 2 Louvered shutter 4 Key punched 6 Wire wrapped 9 Drilled holes
 7 Torch cut 10 Other (specify) _____
 SCREEN-PERFORATED INTERVALS: From 120 ft. to 140 ft. From _____ ft. to _____ ft.
 From _____ ft. to _____ ft. From _____ ft. to _____ ft.
 GRAVEL PACK INTERVALS: From 25 ft. to 140 ft. From _____ ft. to _____ ft.
 From _____ ft. to _____ ft. From _____ ft. to _____ ft.

6 GROUT MATERIAL: 1 Neat cement 2 Cement grout 3 Bentonite 4 Other _____
 Grout Intervals: From 0 ft. to 25 ft. From _____ ft. to _____ ft. From _____ ft. to _____ ft.
 What is the nearest source of possible contamination:
 1 Septic tank 4 Lateral lines None Close 10 Livestock pens 14 Abandoned water well
 2 Sewer lines 5 Cess pool 7 Pit privy 11 Fuel storage 15 Oil well/Gas well
 3 Watertight sewer lines 6 Seepage pit 8 Sewage lagoon 12 Fertilizer storage 16 Other (specify below) _____
 9 Feedyard 13 Insecticide storage
 Direction from well? _____ How many feet? _____

FROM	TO	LITHOLOGIC LOG	FROM	TO	PLUGGING INTERVALS
0	15	Top Soil			
15	6	Brown Clay			
6	8	Limstone			
8	17	Yellow Shale			
17	25	Greenish Shale			
25	55	Brown Shale			
55	63	Limstone			
63	74	Brown Shale			
74	88	Grey Shale			
88	104	Yellow Shale			
104	111	Limstone (Water)			
111	125	Grey Shale			
125	130	Limstone			
130	140	Grey Shale			

7 CONTRACTOR'S OR LANDOWNER'S CERTIFICATION: This water well was (1) constructed, (2) reconstructed, or (3) plugged under my jurisdiction and was completed on (mo/day/year) 9/25/94 and this record is true to the best of my knowledge and belief. Kansas Water Well Contractor's License No. 451 This Water Well Record was completed on (mo/day/yr) 10/26/94 under the business name of Holdeman Well Drilling by (signature) Craig J. Holdeman