


1 LOCATION OF WATER WELL: Fraction NE 1/4 NE 1/4 NW 1/4 Section Number 10 Township Number T 9 S Range Number R 12 EW
 County: POTTAWATOMIE

Distance and direction from nearest town or city street address of well if located within city?
 1 1/8 south of Emmett

2 WATER WELL OWNER: Raymond Eskridge
 RR#, St. Address, Box #: Rt. 1 Box 40 Board of Agriculture, Division of Water Resources
 City, State, ZIP Code: Gallatin, MO 64640 Application Number:

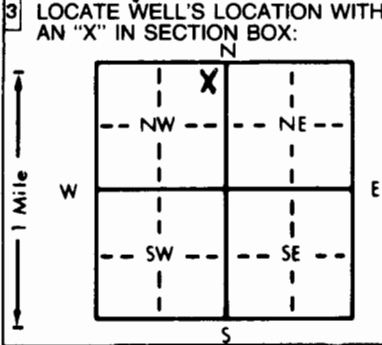

4 DEPTH OF COMPLETED WELL: 160' ft. ELEVATION:
 Depth(s) Groundwater Encountered 1. 75' ft. 2. ft. 3. ft.
 WELL'S STATIC WATER LEVEL: 71' ft. below land surface measured on mo/day/yr 4-28-95
 Pump test data: Well water was ft. after hours pumping gpm
 Est. Yield 4.5 GPH ~~gpm~~ Well water was ft. after hours pumping gpm
 Bore Hole Diameter 8 3/4 in. to ft., and in. to ft.
 WELL WATER TO BE USED AS:
 5 Public water supply 8 Air conditioning 11 Injection well
 1 Domestic 3 Feedlot 6 Oil field water supply 9 Dewatering 12 Other (Specify below)
 2 Irrigation 4 Industrial 7 Lawn and garden only 10 Monitoring well
 Was a chemical/bacteriological sample submitted to Department? Yes No X; If yes, mo/day/yr sample was submitted Water Well Disinfected? Yes X No

5 TYPE OF BLANK CASING USED:
 1 Steel 3 RMP (SR) 5 Wrought iron 8 Concrete tile CASING JOINTS: Glued X Clamped
 2 PVC 4 ABS 6 Asbestos-Cement 9 Other (specify below) Welded
 7 Fiberglass Threaded
 Blank casing diameter 5" in. to 0-70 ft., Dia 5" in. to 90-160 ft., Dia in. to ft.
 Casing height above land surface 24" in., weight 2.82 lbs./ft. Wall thickness or gauge No. 258
 TYPE OF SCREEN OR PERFORATION MATERIAL:
 1 Steel 3 Stainless steel 5 Fiberglass 7 PVC 10 Asbestos-cement
 2 Brass 4 Galvanized steel 6 Concrete tile 8 RMP (SR) 11 Other (specify)
 9 ABS 12 None used (open hole)
 SCREEN OR PERFORATION OPENINGS ARE:
 5 Gauzed wrapped 8 Saw cut 11 None (open hole)
 1 Continuous slot 3 Mill slot 6 Wire wrapped 9 Drilled holes
 2 Louvered shutter 4 Key punched 7 Torch cut 10 Other (specify)
 SCREEN-PERFORATED INTERVALS: From 70 ft. to 90 ft., From ft. to ft.
 GRAVEL PACK INTERVALS: From 24 ft. to 160 ft., From ft. to ft.

6 GROUT MATERIAL: 1 Neat cement 2 Cement grout 3 Bentonite 4 Other
 Grout Intervals: From 4 ft. to 24 ft., From ft. to ft.
 What is the nearest source of possible contamination:
 1 Septic tank 4 Lateral lines 7 Pit privy 10 Livestock pens 14 Abandoned water well
 2 Sewer lines 5 Cess pool 8 Sewage lagoon 11 Fuel storage 15 Oil well/Gas well
 3 Watertight sewer lines 6 Seepage pit 9 Feedyard 12 Fertilizer storage 16 Other (specify below)
 13 Insecticide storage
 Direction from well? west How many feet? 220'

FROM	TO	LITHOLOGIC LOG	FROM	TO	PLUGGING INTERVALS
0	2	Limestone-loose			
2	8	Shale-Yellow			
8	10	Limestone-Yellow			
10	18	Shale-Yellow			
18	19	Limestone-Yellow			
19	22	Shale-Yellow			
22	27	Limestone-Yellow			
27	47	Shale-Yellow			
47	49	Shale-Grey			
49	93	Shale-Yellow			
93	101	Limestone-Yellow			
101	134	Shale-Grey			
134	141	Limestone-Grey			
141	160	Shale-Grey			

7 CONTRACTOR'S OR LANDOWNER'S CERTIFICATION: This water well was (1) constructed, (2) reconstructed, or (3) plugged under my jurisdiction and was completed on (mo/day/year) 4-28-95 and this record is true to the best of my knowledge and belief. Kansas Water Well Contractor's License No. 182 This Water Well Record was completed on (mo/day/yr) 5-25-95 under the business name of STRADER DRILLING CO., INC. by (signature) Dale Eskridge