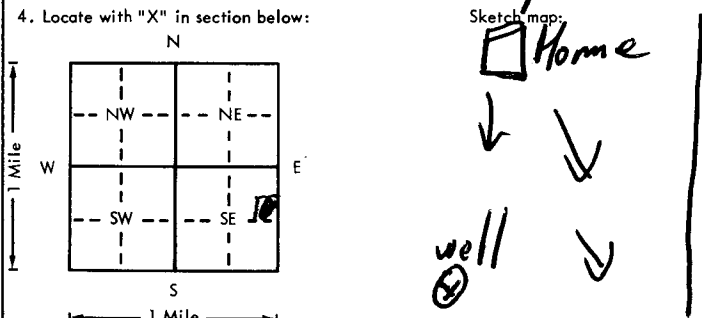


USE TYPEWRITER OR BALL POINT PEN-PRESS FIRMLY, PRINT CLEARLY.

WATER WELL RECORD
KSA 82a-1201-1215

Kansas Department of Health and Environment-Division of Environment
(Water well Contractors)
Topeka, Kansas 66620

dad

| | |
|--|--|
| 1. Location of well: County <u>Jackson</u> Fraction <u>SE 1/4 NE 1/4 SE 1/4</u> Section number <u>1</u> Township number <u>T 9 S</u> Range number <u>R 14 E E/W</u> | |
| 2. Distance and direction from nearest town or city: <u>3 N 4 W of Hoyt</u> 3. Owner of well: <u>Ross Kidd</u> Street address of well location if in city: <u>RT 2 Mayetta KS. 66509</u> City, state, zip code: <u>Mayetta KS. 66509</u> | |
| 4. Locate with "X" in section below:  Sketch map: <u>Home</u> <u>well</u> | |
| 5. Type and color of material | |
| <u>Top Soil</u> | From <u>0</u> To <u>3</u> |
| <u>Glacial</u> | <u>3</u> <u>17</u> |
| <u>Shale grey</u> | <u>17</u> <u>26</u> |
| <u>Lime</u> | <u>26</u> <u>28</u> |
| <u>Shale grey</u> | <u>28</u> <u>42</u> |
| <u>Shale Brown</u> | <u>42</u> <u>47</u> |
| <u>Shale Grey</u> | <u>47</u> <u>66</u> |
| <u>Lime</u> | <u>66</u> <u>67</u> |
| <u>Shale grey</u> | <u>67</u> <u>72</u> |
| <u>Lime</u> | <u>72</u> <u>76</u> |
| <u>Shale grey</u> | <u>76</u> <u>91</u> |
| (Use a second sheet if needed) | |
| 6. Bore hole dia. <u>6 3/4</u> in. Completion date <u>8/22/99</u> Well depth <u>91</u> ft. | 7. <input checked="" type="checkbox"/> Cable tool <input type="checkbox"/> Rotary <input type="checkbox"/> Driven <input type="checkbox"/> Dug <input type="checkbox"/> Hollow rod <input type="checkbox"/> Jetted <input type="checkbox"/> Bored <input type="checkbox"/> Reverse rotary |
| 8. Use: <input checked="" type="checkbox"/> Domestic <input type="checkbox"/> Public supply <input type="checkbox"/> Industry <input type="checkbox"/> Irrigation <input type="checkbox"/> Air conditioning <input type="checkbox"/> Stock <input type="checkbox"/> Lawn <input type="checkbox"/> Oil field water <input type="checkbox"/> Other | |
| 9. Casing: Material <u>PVS</u> Height <u>Above</u> or below Threaded <input type="checkbox"/> Welded <input type="checkbox"/> Surface <u>24</u> in. RMP <u>3</u> PVC <input type="checkbox"/> Weight <input type="checkbox"/> lbs./ft. Dia. <u>3</u> in. to <u>91</u> ft. depth Wall Thickness: inches or Dia. <input type="checkbox"/> in. to <input type="checkbox"/> ft. depth gage No. <u>200</u> | |
| 10. Screen: Manufacturer's name <u>Sun Flower</u> Type <u>RMP</u> Dia. <u>5"</u> Slot/gauze <u>3/16</u> Length <u>74</u> Set between <u>19</u> ft. and <u>91</u> ft. ft. and <input type="checkbox"/> ft. Gravel pack? <u>NO</u> Size range of material <input type="checkbox"/> | |
| 11. Static water level: <u>17</u> ft. below land surface Date <u>8/22/99</u> mo./day/yr. | |
| 12. Pumping level below land surfaces: <input type="checkbox"/> ft. after <input type="checkbox"/> hrs. pumping <input type="checkbox"/> g.p.m. <input type="checkbox"/> ft. after <input type="checkbox"/> hrs. pumping <input type="checkbox"/> g.p.m. Estimated maximum yield <u>76</u> g.p.m. | |
| 13. Water sample submitted: <input type="checkbox"/> Yes <input checked="" type="checkbox"/> No Date <input type="checkbox"/> | |
| 14. Well head completion: <input type="checkbox"/> Pitless adapter <u>24</u> inches above grade | |
| 15. Well grouted? <u>yes</u> With: <input checked="" type="checkbox"/> neat cement <input type="checkbox"/> Bentonite <input type="checkbox"/> Concrete Depth: From <u>0</u> ft. to <u>15</u> ft. | |
| 16. Nearest source of possible contamination: ft. <u>200+</u> Direction <u>North</u> type <u>Septic</u> Well disinfected upon completion? <input checked="" type="checkbox"/> Yes <input type="checkbox"/> No | |
| 17. Pump: <input checked="" type="checkbox"/> Not installed Manufacturer's name <input type="checkbox"/> Model number <input type="checkbox"/> HP <input type="checkbox"/> Volts <input type="checkbox"/> Length of drop pipe <input type="checkbox"/> ft. capacity <input type="checkbox"/> g.p.m. Type: <input type="checkbox"/> Submersible <input type="checkbox"/> Turbine <input type="checkbox"/> Jet <input type="checkbox"/> Reciprocating <input type="checkbox"/> Centrifugal <input type="checkbox"/> Other | |
| 18. Elevation: <u>1110</u> Topography: <input type="checkbox"/> Hill <input type="checkbox"/> Slope <input type="checkbox"/> Upland <input type="checkbox"/> Valley | 19. Remarks: <u>owner to install slab.</u> |
| 20. Water well contractor's certification: This well was drilled under my jurisdiction and this report is true to the best of my knowledge and belief. <u>Robison Drilling 316</u> Business name <u>Permy KS</u> License No. Address <u>Permy KS</u> Signed <u>Jack Robison</u> Date <u>8/22/99</u> Authorized representative | |

9
14
1
SE NE SW
1/4 1/4 1/4

Forward the white, blue and pink copies to the Department of Health and Environment

Form WWC-5

BR = 1093
V = 1093