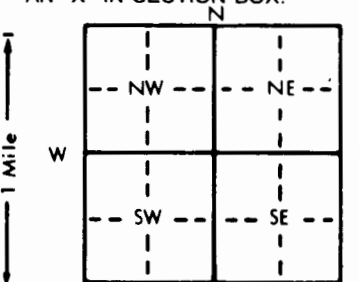


1 LOCATION OF WATER WELL: County: JACKSON Fraction SW 1/4 SW 1/4 NE 1/4 Section Number 9 Township Number T 9 S Range Number R 15E/W

Distance and direction from nearest town or city street address of well if located within city? 3 1/2 south, 1 1/2 west of Mayetta

2 WATER WELL OWNER: Ray White
 RR#, St. Address, Box #: Rt. 1 Box 234
 City, State, ZIP Code: Hoyt, KS 66440
 Board of Agriculture, Division of Water Resources
 Application Number:

3 LOCATE WELL'S LOCATION WITH AN "X" IN SECTION BOX:

 4 DEPTH OF COMPLETED WELL: 38 ft. ELEVATION:
 Depth(s) Groundwater Encountered 1. ft. 2. ft. 3. ft.
 WELL'S STATIC WATER LEVEL . . . 8' . . . ft. below land surface measured on mo/day/yr . . . 7-02-91
 Pump test data: Well water was ft. after hours pumping gpm
 Est. Yield . 50 gpm: Well water was ft. after hours pumping gpm
 Bore Hole Diameter . . . 8 3/4 in. to ft., and in. to ft.
 WELL WATER TO BE USED AS: 5 Public water supply 8 Air conditioning 11 Injection well
 1 Domestic 3 Feedlot 6 Oil field water supply 9 Dewatering 12 Other (Specify below)
 2 Irrigation 4 Industrial 7 Lawn and garden only 10 Monitoring well
 Was a chemical/bacteriological sample submitted to Department? Yes No X; If yes, mo/day/yr sample was sub-
 mitted Water Well Disinfected? Yes X No

5 TYPE OF BLANK CASING USED:
 1 Steel 3 RMP (SR) 5 Wrought iron 8 Concrete tile CASING JOINTS: Glued . X Clamped
 2 PVC 4 ABS 6 Asbestos-Cement 9 Other (specify below) Welded
 7 Fiberglass Threaded
 Blank casing diameter 5" . . . in. to . . . 0-27' . . . ft., Dia in. to ft., Dia in. to ft.
 Casing height above land surface . . . 24" in., weight . . . 2.82 lbs./ft. Wall thickness or gauge No. . . . 258
 TYPE OF SCREEN OR PERFORATION MATERIAL:
 1 Steel 3 Stainless steel 5 Fiberglass 7 PVC 10 Asbestos-cement
 2 Brass 4 Galvanized steel 6 Concrete tile 8 RMP (SR) 11 Other (specify)
 9 ABS 12 None used (open hole)
 SCREEN OR PERFORATION OPENINGS ARE:
 1 Continuous slot 3 Mill slot 5 Gauzed wrapped 8 Saw cut 11 None (open hole)
 2 Louvered shutter 4 Key punched 6 Wire wrapped 9 Drilled holes
 7 Torch cut 10 Other (specify)
 SCREEN-PERFORATED INTERVALS: From . . . 27 ft. to . . . 38 ft., From ft. to ft.
 From ft. to ft., From ft. to ft.
 GRAVEL PACK INTERVALS: From . . . 24 ft. to . . . ~~24~~ 38 ft., From ft. to ft.
 From ft. to ft., From ft. to ft.

6 GROUT MATERIAL: 1 Neat cement 2 Cement grout 3 Bentonite 4 Other hole plug
 Grout intervals: From 4 . . . ft. to . . . 24 ft., From ft. to ft., From ft. to ft.
 What is the nearest source of possible contamination:
 1 Septic tank 4 Lateral lines 7 Pit privy 10 Livestock pens 14 Abandoned water well
 2 Sewer lines 5 Cess pool 8 Sewage lagoon 11 Fuel storage 15 Oil well/Gas well
 3 Watertight sewer lines 6 Seepage pit 9 Feedyard 12 Fertilizer storage 16 Other (specify below) creek
 13 Insecticide storage
 Direction from well? west How many feet? 425'

FROM	TO	LITHOLOGIC LOG	FROM	TO	PLUGGING INTERVALS
0	4	Top Soil			
4	15	Clay-Brown			
15	25	Clay-Blue			
25	32	Chert 1/4x1/2x3/4-Fine Sand-Coarse Sand			
		Grey-Boulders			
32	38	Shale-Grey			

7 CONTRACTOR'S OR LANDOWNER'S CERTIFICATION: This water well was (1) X constructed, (2) reconstructed, or (3) plugged under my jurisdiction and was completed on (mo/day/year) . . . 7-02-91 and this record is true to the best of my knowledge and belief. Kansas Water Well Contractor's License No. . . 182 This Water Well Record was completed on (mo/day/yr) . . . 8-12-91 under the business name of STRADER DRILLING CO., INC. by (signature) Dale Dobson

OFFICE USE ONLY
T
R
EW
SEC.
1/4
1/4
1/4