

109A ✓

Elmont PCC


130

1 LOCATION OF WATER WELL: Fraction SW 1/4 SW 1/4 SE 1/4 Section Number 21 Township Number T 9 S Range Number R 15 E

Distance and direction from nearest town or city street address of well if located within city? 1/4 mile south 2 1/2 miles west of Hoyt Bldg. site

2 WATER WELL OWNER: Ina Koch RR# , St. Address, Box # : RR 1 City, State, ZIP Code : Hoyt, KS 66440 Board of Agriculture, Division of Water Resources Application Number:

3 LOCATE WELL'S LOCATION WITH AN "X" IN SECTION BOX: 4 DEPTH OF COMPLETED WELL: 55 ft. ELEVATION: 1062.2M

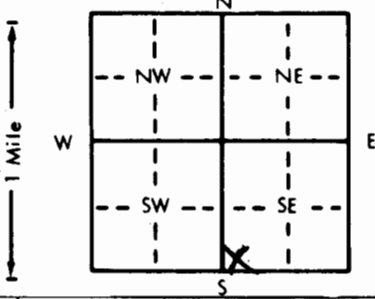

Depth(s) Groundwater Encountered 1. 17 ft. 2. ft. 3. ft. WELL'S STATIC WATER LEVEL 9 ft. below land surface measured on mo/day/yr 11-10-81 Pump test data: Well water was ft. after hours pumping gpm Est. Yield 1 gpm: Well water was ft. after hours pumping gpm Bore Hole Diameter: 8 1/2 in. to 55 ft., and in. to ft. WELL WATER TO BE USED AS: 5 Public water supply 8 Air conditioning 11 Injection well ① Domestic 3 Feedlot 6 Oil field water supply 9 Dewatering 12 Other (Specify below) 2 Irrigation 4 Industrial 7 Lawn and garden only 10 Observation well Was a chemical/bacteriological sample submitted to Department? Yes No X; If yes, mo/day/yr sample was submitted Water Well Disinfected? Yes X No

5 TYPE OF BLANK CASING USED: 1 Steel 3 RMP (SR) 5 Wrought iron 8 Concrete tile CASING JOINTS: Glued X Clamped 2 PVC 4 ABS 6 Asbestos-Cement 9 Other (specify below) Welded 7 Fiberglass Threaded

Blank casing diameter 5 in. to 15 ft., Dia 3 in. to 0 ft. Casing height above land surface 18" in., weight .214 lbs./ft. Wall thickness or gauge No.

TYPE OF SCREEN OR PERFORATION MATERIAL: 1 Steel 3 Stainless steel 5 Fiberglass 7 PVC 10 Asbestos-cement 2 Brass 4 Galvanized steel 6 Concrete tile 8 RMP (SR) 11 Other (specify) 9 ABS 12 None used (open hole)

SCREEN OR PERFORATION OPENINGS ARE: 1 Continuous slot 3 Mill slot 5 Gauzed wrapped 8 Saw cut 11 None (open hole) 2 Louvered shutter 4 Key punched 6 Wire wrapped 9 Drilled holes 7 Torch cut 10 Other (specify)

SCREEN-PERFORATED INTERVALS: From 55 ft. to 45 ft., From 25 ft. to 15 ft. GRAVEL PACK INTERVALS: From 55 ft. to 15 ft., From ft. to ft.

6 GROUT MATERIAL: 1 Neat cement 2 Cement grout 3 Bentonite 4 Other Grout intervals: From 3 ft. to 15 ft., From ft. to ft., From ft. to ft.

What is the nearest source of possible contamination: 1 Septic tank 4 Lateral lines 7 Pit privy 10 Livestock pens 14 Abandoned water well ② Sewer lines 5 Cess pool 8 Sewage lagoon 11 Fuel storage 15 Oil well/Gas well 3 Watertight sewer lines 6 Seepage pit 9 Feedyard 12 Fertilizer storage 16 Other (specify below) 13 Insecticide storage Direction from well? EAST How many feet? 100 FT.

FROM	TO	LITHOLOGIC LOG	FROM	TO	LITHOLOGIC LOG
0	9	Redish BROWN clay			
9'-6"	17	GRAY clay			
17	17'-6"	Redish ROCK			
17'-6"	49	Till			
49	49'-6"	ROCK			
49	55	Till			

7 CONTRACTOR'S OR LANDOWNER'S CERTIFICATION: This water well was (1) constructed, (2) reconstructed, or (3) plugged under my jurisdiction and was completed on (mo/day/year) 11-10-81 and this record is true to the best of my knowledge and belief. Kansas Water Well Contractor's License No. 405 This Water Well Record was completed on (mo/day/yr) 12-5-81 under the business name of Haworth Drilling by (signature) Walter J. Haworth

INSTRUCTIONS: Use typewriter or ball point pen, PLEASE PRESS FIRMLY and PRINT clearly. Please fill in blanks, underline or circle the correct answers. Send top three copies to Kansas Department of Health and Environment, Division of Environment, Environmental Geology Section, Topeka, KS 66620. Send one to WATER WELL OWNER and retain one for your records.

OFFICE USE ONLY

9

H

15

DM

SEC.

21

SW 1/4

SW 1/4

SE 1/4

145