


1 LOCATION OF WATER WELL: County: JACKSON Fraction: NW 1/4 SE 1/4 SW 1/4 Section Number: 21 Township Number: T 9 S Range Number: R 15E E/W

Distance and direction from nearest town or city street address of well if located within city?  
1 3/4 west of Mayetta

2 WATER WELL OWNER: LeRoy Steinbach  
RR#, St. Address, Box #: 316 NE St. John Board of Agriculture, Division of Water Resources  
City, State, ZIP Code: Topeka, KS 66608-1166 Application Number:

3 LOCATE WELL'S LOCATION WITH AN "X" IN SECTION BOX:  
4 DEPTH OF COMPLETED WELL: 80' ft. ELEVATION:  
Depth(s) Groundwater Encountered 1. 15' ft. 2. ft. 3. ft.  
WELL'S STATIC WATER LEVEL: 3' ft. below land surface measured on mo/day/yr 1/26/98  
Pump test data: Well water was ft. after hours pumping gpm  
Est. Yield: 1 1/2 gpm; Well water was ft. after hours pumping gpm  
Bore Hole Diameter: 12" in. to ft., and in. to ft.  
WELL WATER TO BE USED AS:  
5 Public water supply 8 Air conditioning 11 Injection well  
1 Domestic 3 Feedlot 6 Oil field water supply 9 Dewatering 12 Other (Specify below)  
2 Irrigation 4 Industrial 7 Lawn and garden only 10 Monitoring well  
Was a chemical/bacteriological sample submitted to Department? Yes No X; If yes, mo/day/yr sample was submitted  
Water Well Disinfected? Yes X No

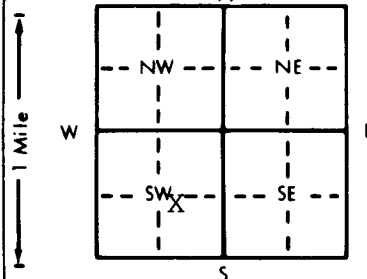

5 TYPE OF BLANK CASING USED:  
1 Steel 3 RMP (SR) 5 Wrought iron 8 Concrete tile CASING JOINTS: Glued X Clamped  
2 PVC 4 ABS 6 Asbestos-Cement 9 Other (specify below) Welded  
7 Fiberglass Threaded  
Blank casing diameter: 5" in. to 0-14 ft. Dia. 5" in. to 20-79 ft. Dia. in. to ft.  
Casing height above land surface: 24" in. weight 2.82 lbs./ft. Wall thickness or gauge No. .258

TYPE OF SCREEN OR PERFORATION MATERIAL:  
1 Steel 3 Stainless steel 5 Fiberglass 7 PVC 10 Asbestos-cement  
2 Brass 4 Galvanized steel 6 Concrete tile 8 RMP (SR) 11 Other (specify)  
12 None used (open hole)

SCREEN OR PERFORATION OPENINGS ARE:  
1 Continuous slot 3 Mill slot 5 Gauzed wrapped 8 Saw cut 11 None (open hole)  
2 Louvered shutter 4 Key punched 6 Wire wrapped 9 Drilled holes  
7 Torch cut 10 Other (specify)

SCREEN-PERFORATED INTERVALS: From 14 ft. to 20 ft., From ft. to ft.  
From 79 ft. to 80 ft., From ft. to ft.  
GRAVEL PACK INTERVALS: From 13 ft. to 80 ft., From ft. to ft.  
From ft. to ft., From ft. to ft.

6 GROUT MATERIAL: 1 Neat cement 2 Cement grout 3 Bentonite 4 Other  
Grout Intervals: From 0 ft. to 13 ft., From ft. to ft., From ft. to ft.  
What is the nearest source of possible contamination:  
1 Septic tank 4 Lateral lines 7 Pit privy 10 Livestock pens 14 Abandoned water well  
2 Sewer lines 5 Cess pool 8 Sewage lagoon 11 Fuel storage 15 Oil well/Gas well  
3 Watertight sewer lines 6 Seepage pit 9 Feedyard 12 Fertilizer storage 16 Other (specify below)  
13 Insecticide storage pond  
Direction from well? NORTH How many feet? 50'

FROM	TO	LITHOLOGIC LOG	FROM	TO	PLUGGING INTERVALS
0	3	Top Soil			
3	15	Clay-Brown			
15	17	Fine Sand-coarse Sand-Med Gravel-Br			
17	43	Clay-Brown			
43	67	Clay-Blue			
67	68	Limestone-Grey			
68	74	Shale-Grey			
74	75	Shale-Red			
75	80	Shale-Grey			

7 CONTRACTOR'S OR LANDOWNER'S CERTIFICATION: This water well was (1) constructed, (2) reconstructed, or (3) plugged under my jurisdiction and was completed on (mo/day/year) 1/26/98 and this record is true to the best of my knowledge and belief. Kansas Water Well Contractor's License No. 182 This Water Well Record was completed on (mo/day/yr) 2-11-98 under the business name of STRADER DRILLING CO., INC. by (signature) Dale Bakren

OFFICE USE ONLY T R E W SEC. 1/4 1/4 1/4