


1 LOCATION OF WATER WELL: Fraction Section Number Township Number Range Number  
 County: JACKSON SE 1/4 NE 1/4 NE 1/4 16 T 9 S R 16 EW

Distance and direction from nearest town or city street address of well if located within city?  
 4 east, 1 north of Hoyt

2 WATER WELL OWNER: Ron Reeves  
 RR#, St. Address, Box #: Box 99 Rt. 1 Board of Agriculture, Division of Water Resources  
 City, State, ZIP Code: Hoyt, KS 66440 Application Number:

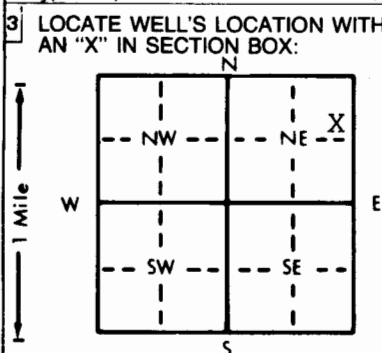

4 DEPTH OF COMPLETED WELL: 54' ft. ELEVATION:  
 Depth(s) Groundwater Encountered 1. 17' ft. 2. ft. 3. ft.  
 WELL'S STATIC WATER LEVEL: 10' ft. below land surface measured on mo/day/yr 3-03-92  
 Pump test data: Well water was ft. after hours pumping gpm  
 Est. Yield .8 gpm: Well water was ft. after hours pumping gpm  
 Bore Hole Diameter in. to ft., and in. to ft.  
 WELL WATER TO BE USED AS:  
 1 Domestic 3 Feedlot 6 Oil field water supply 9 Dewatering 12 Other (Specify below)  
 2 Irrigation 4 Industrial 7 Lawn and garden only 10 Monitoring well  
 Was a chemical/bacteriological sample submitted to Department? Yes No ; If yes, mo/day/yr sample was submitted  
 Water Well Disinfected? Yes  No

5 TYPE OF BLANK CASING USED:  
 1 Steel 3 RMP (SR) 5 Wrought iron 8 Concrete tile CASING JOINTS: Glued  Clamped  
 2 PVC 5" 4 ABS 6 Asbestos-Cement 9 Other (specify below) Welded  
 7 Fiberglass Threaded  
 Blank casing diameter 5" in. to 0-16 ft., Dia 5" in. to 21-49 ft., Dia in. to ft.  
 Casing height above land surface 24" in., weight ~~2.82~~ lbs./ft. Wall thickness or gauge No. 258  
 TYPE OF SCREEN OR PERFORATION MATERIAL:  
 1 Steel 3 Stainless steel 5 Fiberglass 7 PVC 10 Asbestos-cement  
 2 Brass 4 Galvanized steel 6 Concrete tile 8 RMP (SR) 11 Other (specify)  
 12 None used (open hole)  
 SCREEN OR PERFORATION OPENINGS ARE:  
 1 Continuous slot 3 Mill slot 5 Gauzed wrapped 8 Saw cut 11 None (open hole)  
 2 Louvered shutter 4 Key punched 6 Wire wrapped 9 Drilled holes  
 7 Torch cut 10 Other (specify)  
 SCREEN-PERFORATED INTERVALS: From 16 ft. to 21 ft., From ft. to ft.  
 From 49 ft. to 54 ft., From ft. to ft.  
 GRAVEL PACK INTERVALS: From 14 ft. to 54 ft., From ft. to ft.  
 From ft. to ft., From ft. to ft.

6 GROUT MATERIAL: 1 Neat cement 2 Cement grout 3 Bentonite 4 Other  
 Grout Intervals: From 0 ft. to 14 ft., From ft. to ft., From ft. to ft.  
 What is the nearest source of possible contamination:  
 1 Septic tank 4 Lateral lines 7 Pit privy 10 Livestock pens 14 Abandoned water well  
 2 Sewer lines 5 Cess pool 8 Sewage lagoon 11 Fuel storage 15 Oil well/Gas well  
 3 Watertight sewer lines 6 Seepage pit 9 Feedyard 12 Fertilizer storage 16 Other (specify below)  
 13 Insecticide storage  
 Direction from well? west How many feet? 130'

FROM	TO	LITHOLOGIC LOG	FROM	TO	PLUGGING INTERVALS
0	3	Top Soil			
3	32	Clay-Brown			
32	54	Shale-Grey			
					NOTE: Permission from Don Taylor to shallow grout 3-4-92

7 CONTRACTOR'S OR LANDOWNER'S CERTIFICATION: This water well was (1) constructed, (2) reconstructed, or (3) plugged under my jurisdiction and was completed on (mo/day/year) 3-03-92 and this record is true to the best of my knowledge and belief. Kansas Water Well Contractor's License No. 182 This Water Well Record was completed on (mo/day/yr) 4-7-92 under the business name of STRADER DRILLING CO., INC. by (signature) Dale Strader