

**WATER WELL RECORD**

**Form WWC-5**


Division of Water Resources App. No.  

**1 LOCATION OF WATER WELL:** Section NW  
 County: Jefferson 1/4 NW 1/4 NW 1/4 NW 1/4 Section Number 36 Township No. T 9 S Range Number R 16  E  W

Street/Rural Address of Well Location; if unknown, distance & direction from nearest town or intersection: If at owner's address, check here   
 9868 Sherman Road Meriden, KS 66512

**Global Positioning System (GPS) information:**  
 Latitude: ..... (in decimal degrees)  
 Longitude: ..... (in decimal degrees)  
 Elevation: .....  
 Datum:  WGS 84,  NAD 83,  NAD 27  
 Collection Method:  
 GPS unit (Make/Model: .....)  
 Digital Map/Photo,  Topographic Map,  Land Survey  
 Est. Accuracy:  <3 m,  3-5 m,  5-15 m,  >15 m

**2 WATER WELL OWNER:** Darrin Greene  
 RR#, Street Address, Box #: 10800 Merriden Road  
 City, State, ZIP Code : Meriden, KS 66512

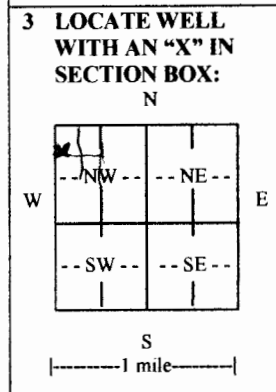

**4 DEPTH OF COMPLETED WELL** 200 ft. 4-200' Bores  
 Depth(s) Groundwater Encountered (1). None ft. (2)..... ft. (3)..... ft.  
 WELL'S STATIC WATER LEVEL. None ft. below land surface measured on mo/day/yr.....  
 Pump test data: Well water was.....ft. after..... hours pumping..... gpm  
 EST. YIELD...0...gpm. Well water was.....ft. after..... hours pumping..... gpm  
 Bore Hole Diameter 6.....in. to .....ft., and .....in. to .....ft.  
 WELL WATER TO BE USED AS:  Public water supply  Geothermal  Injection well  
 Domestic  Feedlot  Oil field water supply  Dewatering  Other (Specify below)  
 Irrigation  Industrial  Domestic-lawn & garden  Monitoring well  closed loop  
 Was a chemical/bacteriological sample submitted to Department?  Yes  No  
 If yes, mo/day/yr sample was submitted.....  
 Water well disinfected?  Yes  No

**5 TYPE OF CASING USED:**  Steel  PVC  Other HD Polyethylene  
 CASING JOINTS:  Glued  Clamped  Welded  Threaded  
 Casing diameter 3/4 in. to 200 ft., Diameter ..... in. to ..... ft., Diameter ..... in. to ..... ft.  
 Casing height above land surface 36 in., Weight SDR11 lbs./ft., Wall thickness or gauge No. 160 PSI  
 TYPE OF SCREEN OR PERFORATION MATERIAL: None  
 Steel  Stainless Steel  PVC  Other (Specify) .....  
 Brass  Galvanized Steel  None used (open hole)  
 SCREEN OR PERFORATION OPENINGS ARE: None  
 Continuous slot  Mill slot  Gauze wrapped  Torch cut  Drilled holes  None (open hole)  
 Louvered shutter  Key punched  Wire wrapped  Saw cut  Other (specify) .....  
 SCREEN-PERFORATED INTERVALS: From..... ft. to ..... ft., From..... ft. to ..... ft.  
 GRAVEL PACK INTERVALS: From..... ft. to ..... ft., From..... ft. to ..... ft.

**6 GROUT MATERIAL:**  Neat cement  Cement grout  Bentonite  Other .....  
 Grout Intervals: From 200 ft. to 3 ft., From ..... ft. to ..... ft., From ..... ft. to ..... ft.  
 What is the nearest source of possible contamination: None  
 Septic tank  Lateral lines  Pit privy  Livestock pens  Insecticide storage  Other (specify below)  
 Sewer lines  Cesspool  Sewage lagoon  Fuel storage  Abandoned water well  
 Watertight sewer lines  Seepage pit  Feedyard  Fertilizer storage  Oil well/gas well  
 Direction from well ..... Distance from well .....

FROM	TO	LITHOLOGIC LOG	FROM	TO	LITHO. LOG (cont.) or PLUGGING INTERVALS
0	10	soil & clay 120-150 shale			
10	14	sandstone 150-152 lime			
14	19	clay 152-155 shale			
19	24	sandstone 155-157 lime	200	3	4-200' bores plugged with
24	25	shale 157-165 sandstone			High Solid Bentonite
25	70	sandstone 165-170 lime			
70	98	shale 170-200 shale			
98	99	lime			
99	104	shale			
104	120	sandstone			

**7 CONTRACTOR'S OR LANDOWNER'S CERTIFICATION:** This water well was  constructed,  reconstructed, or  plugged under my jurisdiction and was completed on (mo/day/year) 6.26.13 and this record is true to the best of my knowledge and belief. Kansas Water Well Contractor's License No. 561 This Water Well Record was completed on (mo/day/year) 6.27.13 under the business name of Evans Energy Development, Inc. by (signature) [Signature]

**INSTRUCTIONS:** Use typewriter or ball point pen. PLEASE PRESS FIRMLY and PRINT clearly. Please fill in blanks and check the correct answers. Send one copy to Kansas Department of Health and Environment, Bureau of Water, Geology Section, 1000 SW Jackson St., Suite 420, Topeka, Kansas 66612-1367. Telephone 785-296-5524. Send one copy to WATER WELL OWNER and retain one for your records. Include fee of \$5.00 for each constructed well. Visit us at <http://www.kdheks.gov/waterwell/index.html>