


1 LOCATION OF WATER WELL:	Fraction	Section Number	Township Number	Range Number
County: JEFFERSON	SE 1/4 SW 1/4 NW 1/4	30	T 9 S	R 17 EW

Distance and direction from nearest town or city street address of well if located within city?

4 north of Meriden

2 WATER WELL OWNER: Mrs. Ann Paden
 RR#, St. Address, Box #: Box E
 City, State, ZIP Code: Meriden, KS 66512
 Board of Agriculture, Division of Water Resources
 Application Number:

3 LOCATE WELL'S LOCATION WITH AN "X" IN SECTION BOX:

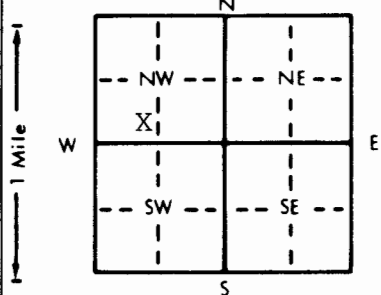

4 DEPTH OF COMPLETED WELL: 169' ft. ELEVATION: _____ ft.

Depth(s) Groundwater Encountered 1. _____ ft. 2. _____ ft. 3. _____ ft.

WELL'S STATIC WATER LEVEL: 80' ft. below land surface measured on mo/day/yr 9/24/96

Pump test data: Well water was _____ ft. after _____ hours pumping _____ gpm

Est. Yield: 4 gpm: Well water was _____ ft. after _____ hours pumping _____ gpm

Bore Hole Diameter: 8 3/4 in. to _____ ft., and _____ in. to _____ ft.

WELL WATER TO BE USED AS:

5 Public water supply	8 Air conditioning	11 Injection well
1 Domestic	3 Feedlot	6 Oil field water supply
2 Irrigation	4 Industrial	7 Lawn and garden only
		10 Monitoring well
		9 Dewatering
		12 Other (Specify below)

Was a chemical/bacteriological sample submitted to Department? Yes _____ No ; If yes, mo/day/yr sample was submitted _____

Water Well Disinfected? Yes No _____

5 TYPE OF BLANK CASING USED:

1 Steel	3 RMP (SR)	5 Wrought iron	8 Concrete tile	CASING JOINTS: Glued <input checked="" type="checkbox"/> Clamped _____
2 PVC	4 ABS	6 Asbestos-Cement	9 Other (specify below)	Welded _____
		7 Fiberglass		Threaded _____

Blank casing diameter: 5" in. to 0-120 ft., Dia 5" in. to 160-169 ft., Dia _____ in. to _____ ft.

Casing height above land surface: 24" in., weight 2.82 lbs./ft. Wall thickness or gauge No. 258

TYPE OF SCREEN OR PERFORATION MATERIAL:

1 Steel	3 Stainless steel	5 Fiberglass	8 RMP (SR)	10 Asbestos-cement	11 Other (specify) _____
2 Brass	4 Galvanized steel	6 Concrete tile	9 ABS	12 None used (open hole)	

SCREEN OR PERFORATION OPENINGS ARE:

1 Continuous slot	3 Mill slot	5 Gauzed wrapped	8 Saw cut	11 None (open hole)
2 Louvered shutter	4 Key punched	6 Wire wrapped	9 Drilled holes	
		7 Torch cut	10 Other (specify) _____	

SCREEN-PERFORATED INTERVALS: From 120 ft. to 160 ft., From _____ ft. to _____ ft.

GRAVEL PACK INTERVALS: From 24 ft. to 169 ft., From _____ ft. to _____ ft.

6 GROUT MATERIAL: 1 Neat cement 2 Cement grout 3 Bentonite 4 Other _____

Grout Intervals: From 4 ft. to 24 ft., From _____ ft. to _____ ft., From _____ ft. to _____ ft.

What is the nearest source of possible contamination:

1 Septic tank	4 Lateral lines	7 Pit privy	10 Livestock pens	14 Abandoned water well
2 Sewer lines	5 Cess pool	8 Sewage lagoon	11 Fuel storage	15 Oil well/Gas well
3 Watertight sewer lines	6 Seepage pit	9 Feedyard	12 Fertilizer storage	16 Other (specify below)
			13 Insecticide storage	

Direction from well? west How many feet? 100'

FROM	TO	LITHOLOGIC LOG	FROM	TO	PLUGGING INTERVALS
0	2	Clay-Brown	162	169	Limestone-Grey
2	6	Shale-Yellow			
6	8	Sandstone-Yellow			
8	72	Shale-Grey			
72	96	Sandy Shale-Grey			
96	102	Sandstone-Grey-Silty			
102	105	Limestone-Grey			
105	108	Sandstone-Grey			
108	110	Shale-Grey			
110	115	Sandstone-Grey			
115	128	Sandy Shale-Grey			
128	142	Sandstone-Grey			
142	143	Limestone-Grey			
143	145	Sandstone-Grey			
155	162	Shale-Grey			

7 CONTRACTOR'S OR LANDOWNER'S CERTIFICATION: This water well was (1) constructed, (2) reconstructed, or (3) plugged under my jurisdiction and was completed on (mo/day/year) 9/24/96 and this record is true to the best of my knowledge and belief. Kansas Water Well Contractor's License No. 182 This Water Well Record was completed on (mo/day/yr) 10-18-96 under the business name of STRADER DRILLING CO., INC. by signature *W. Strader*