


1 LOCATION OF WATER WELL: County: Jefferson	Fraction SW 1/4 SW 1/4 SW 1/4	Section Number 35	Township Number T 9 S	Range Number R 17 E/W
--	----------------------------------	----------------------	--------------------------	--------------------------

Distance and direction from nearest town or city street address of well if located within city?  
Approximately 1 mile south and 1 3/4 miles west of Ozawkie

2 WATER WELL OWNER: Jefferson County RWD #11  
 RR#, St. Address, Box #: Lake Ridge Parkway, Route 1 - Box 499A  
 City, State, ZIP Code: Ozawkie, KS 66070  
 Board of Agriculture, Division of Water Resources  
 Application Number: 41,291

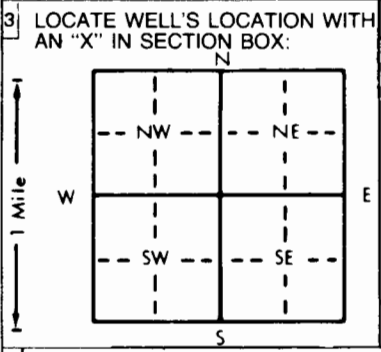

4 DEPTH OF COMPLETED WELL: 98 ft. ELEVATION: unknown

Depth(s) Groundwater Encountered 1. . . . . ft. 2. . . . . ft. 3. . . . . ft.

WELL'S STATIC WATER LEVEL . . . . . 39 . . . . . ft. below land surface measured on mo/day/yr . . . . . 11-15-96

Pump test data: Well water was not ch'd. ft. after . . . . . hours pumping . . . . . gpm

Est. Yield unknown gpm: Well water was . . . . . ft. after . . . . . hours pumping . . . . . gpm

Bore Hole Diameter . . . . . 36 . . . . . in. to . . . . . 100 . . . . . ft., and . . . . . in. to . . . . . ft.

WELL WATER TO BE USED AS:

5 Public water supply	8 Air conditioning	11 Injection well
1 Domestic	3 Feedlot	6 Oil field water supply
2 Irrigation	4 Industrial	7 Lawn and garden only
		9 Dewatering
		10 Monitoring well
		12 Other (Specify below)

Was a chemical/bacteriological sample submitted to Department? Yes . . . . . No ; If yes, mo/day/yr sample was submitted

Water Well Disinfected? Yes  No

5 TYPE OF BLANK CASING USED:

1 Steel	3 RMP (SR)	5 Wrought iron	8 Concrete tile	CASING JOINTS: Glued . . . . . Clamped . . . . .
2 PVC	4 ABS	6 Asbestos-Cement	9 Other (specify below)	Welded <input checked="" type="checkbox"/>
		7 Fiberglass		Threaded . . . . .

Blank casing diameter . . . . . 12 3/4 . . . . . in. to . . . . . 74.5 . . . . . ft., Dia . . . . . in. to . . . . . ft., Dia . . . . . in. to . . . . . ft.

Casing height above land surface . . . . . 6 . . . . . in, weight . . . . . 49.56 . . . . . lbs./ft. Wall thickness or gauge No. . . . . 375

TYPE OF SCREEN OR PERFORATION MATERIAL:

1 Steel	3 Stainless steel	5 Fiberglass	8 RMP (SR)	10 Asbestos-cement	11 Other (specify)
2 Brass	4 Galvanized steel	6 Concrete tile	9 ABS	12 None used (open hole)	

SCREEN OR PERFORATION OPENINGS ARE:

1 Continuous slot	3 Mill slot	5 Gauzed wrapped	8 Saw cut	11 None (open hole)
2 Louvered shutter	4 Key punched	6 Wire wrapped	9 Drilled holes	
		7 Torch cut	10 Other (specify)	

SCREEN-PERFORATED INTERVALS: From . . . . . 74.5 . . . . . ft. to . . . . . 94.5 . . . . . ft., From . . . . . ft. to . . . . . ft.

GRAVEL PACK INTERVALS: From . . . . . 61 . . . . . ft. to . . . . . 100 . . . . . ft., From . . . . . ft. to . . . . . ft.

6 GROUT MATERIAL: 1 Neat cement, 2 Cement grout, 3 Bentonite, 4 Other 50% Bentonite Holeplug and 50% Chlorinated sand

Grout Intervals: From . . . . . 0 . . . . . ft. to . . . . . 5 . . . . . ft., From . . . . . 5 . . . . . ft. to . . . . . 25 . . . . . ft., From . . . . . 25 . . . . . ft. to . . . . . 61 . . . . . ft.

What is the nearest source of possible contamination:

1 Septic tank	4 Lateral lines	7 Pit privy	10 Livestock pens	14 Abandoned water well
2 Sewer lines	5 Cess pool	8 Sewage lagoon	11 Fuel storage	15 Oil well/Gas well
3 Watertight sewer lines	6 Seepage pit	9 Feedyard	12 Fertilizer storage	16 Other (specify below)
			13 Insecticide storage	None known

Direction from well? How many feet?

FROM	TO	LITHOLOGIC LOG	FROM	TO	PLUGGING INTERVALS
0	2	Topsoil			
2	17	Clay, brown with boulders			
17	26	Clay, blue and brown			
26	28	Clay with limestone			
28	38	Boulders and rocks			
38	54	Sand, fine, medium with boulders			
54	58	Sand, fine			
58	61	Sand and clay, blue			
61	67	Sand, fine			
67	89	Sand, fine, medium			
89	92	Sand, fine with boulders			
92	100	Sand, very fine to fine			

7 CONTRACTOR'S OR LANDOWNER'S CERTIFICATION: This water well was (1) constructed, (2) reconstructed, or (3) plugged under my jurisdiction and was completed on (mo/day/year) . . . . . 11-15-96 . . . . . and this record is true to the best of my knowledge and belief. Kansas Water Well Contractor's License No. . . . . 185 . . . . . This Water Well Record was completed on (mo/day/yr) . . . . . 11-20-96 . . . . . under the business name of Clarke Well & Equipment, Inc. by (signature) *Clarke Well & Equipment*