


1 LOCATION OF WATER WELL: County: Jefferson	Fraction SW 1/4 SW 1/4 SW 1/4	Section Number 35	Township Number T 9 S	Range Number R 17 E XX
--	----------------------------------	----------------------	--------------------------	--------------------------------------

Distance and direction from nearest town or city street address of well if located within city?
 Approximately 1 mile south and 1 3/4 miles west of Ozawkie

2 WATER WELL OWNER: Jefferson County RWD #1
 RR#, St. Address, Box #: Lake Ridge Parkway
 City, State, ZIP Code: Ozawkie, KS 66070
 Board of Agriculture, Division of Water Resources
 Application Number: 41,292

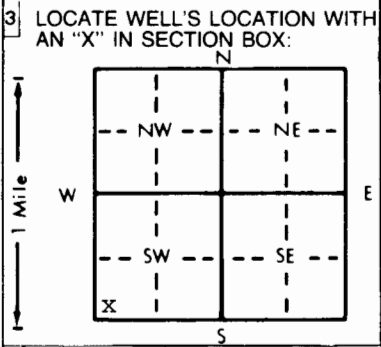

4 DEPTH OF COMPLETED WELL: 106 ft. ELEVATION: unknown

Depth(s) Groundwater Encountered 1. ft. 2. ft. 3. ft.

WELL'S STATIC WATER LEVEL 35 ft. below land surface measured on mo/day/yr 11-21-96

Pump test data: Well water was not ch'd ft. after hours pumping gpm

Est. Yield unknown gpm: Well water was ft. after hours pumping gpm

Bore Hole Diameter 36 in. to 109 ft., and in. to ft.

WELL WATER TO BE USED AS:

1 Domestic	3 Feedlot	6 Oil field water supply	8 Air conditioning	11 Injection well
2 Irrigation	4 Industrial	7 Lawn and garden only	9 Dewatering	12 Other (Specify below)

Was a chemical/bacteriological sample submitted to Department? Yes No X; If yes, mo/day/yr sample was submitted

Water Well Disinfected? Yes X No

5 TYPE OF BLANK CASING USED:

1 Steel	3 RMP (SR)	5 Wrought iron	8 Concrete tile	CASING JOINTS: Glued Clamped
2 PVC	4 ABS	6 Asbestos-Cement	9 Other (specify below)	Welded X
		7 Fiberglass		Threaded

Blank casing diameter 12 3/4 in. to 82 ft., Dia 12 3/4 in. to 105 ft., Dia in. to ft.

Casing height above land surface 12 in., weight 49.56 lbs./ft. Wall thickness or gauge No. 375

TYPE OF SCREEN OR PERFORATION MATERIAL:

1 Steel	3 Stainless steel	5 Fiberglass	8 RMP (SR)	10 Asbestos-cement	11 Other (specify)
2 Brass	4 Galvanized steel	6 Concrete tile	9 ABS	12 None used (open hole)	

SCREEN OR PERFORATION OPENINGS ARE:

1 Continuous slot	3 Mill slot	5 Gauzed wrapped	8 Saw cut	11 None (open hole)
2 Louvered shutter	4 Key punched	6 Wire wrapped	9 Drilled holes	
		7 Torch cut	10 Other (specify)	

SCREEN-PERFORATED INTERVALS: From 82 ft. to 102 ft., From ft. to ft.

GRAVEL PACK INTERVALS: From 66 ft. to 109 ft., From ft. to ft.

6 GROUT MATERIAL: 1 Neat cement, 2 Cement grout, 3 Bentonite, 4 Other, 50% Bentonite Holeplug and 50% Chlorinated Sand

Grout Intervals: From 0 ft. to 5 ft., From 5 ft. to 25 ft., From 25 ft. to 60 ft.

What is the nearest source of possible contamination:

1 Septic tank	4 Lateral lines	7 Pit privy	10 Livestock pens	14 Abandoned water well
2 Sewer lines	5 Cess pool	8 Sewage lagoon	11 Fuel storage	15 Oil well/Gas well
3 Watertight sewer lines	6 Seepage pit	9 Feedyard	12 Fertilizer storage	16 Other (specify below)
			13 Insecticide storage	None known

Direction from well? How many feet?

FROM	TO	LITHOLOGIC LOG	FROM	TO	PLUGGING INTERVALS
0	2	Topsoil			
2	15	Clay, brown			
15	23	Clay, blue			
23	25	Clay and sand, fine			
25	36	Clay, blue			
36	40	Clay with sand and boulders			
40	46	Sand and boulders			
46	60	Sand, fine, medium, coarse			
60	82	Sand, fine with boulders			
82	96	A lot of boulders and sand, medium			
96	109	Sand, fine			

7 CONTRACTOR'S OR LANDOWNER'S CERTIFICATION: This water well was (1) constructed, (2) reconstructed, or (3) plugged under my jurisdiction and was completed on (mo/day/year) 11-21-96 and this record is true to the best of my knowledge and belief. Kansas Water Well Contractor's License No. 185 This Water Well Record was completed on (mo/day/yr) 11-27-96 under the business name of Clarke Well & Equipment, Inc. by (signature) *Clarke Well & Equipment, Inc.*

OFFICE USE ONLY

T

R

EW

SEC.

1/4

1/4

1/4