

26

3 J 10-80-6

checked MHE

JBRT

USE TYPEWRITER OR BALL POINT PEN-PRESS FIRMLY, PRINT CLEARLY.

WATER WELL RECORD
KSA 82a-1201-1215

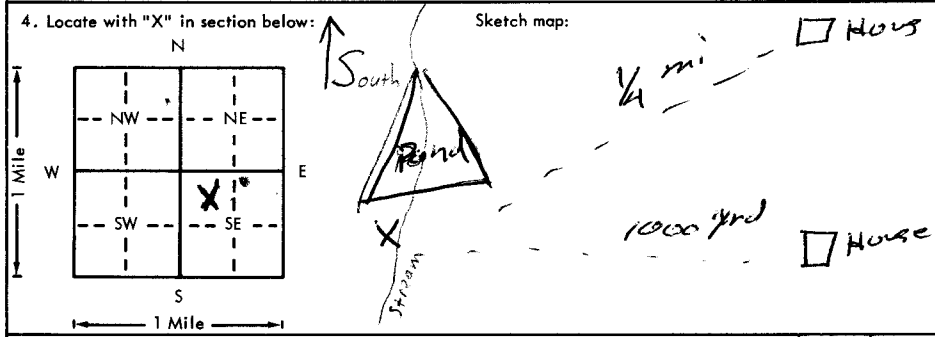
Kansas Department of Health and Environment-Division of Environment
(Water well Contractors)
Topeka, Kansas 66620

dab

1. Location of well: County Jefferson Fraction SW corner, NE 1/4, SE 1/4 Section number 22 Township number T 9 S R 17 Range number EW

2. Distance and direction from nearest town or city: 2 mi. W / 1 1/2 N. Street address of well location if in city: of Ozawkie, Ks.

3. Owner of well: Eugene Herring R.R. or street: RR 1 Ozawkie, Ks City, state, zip code:

4. Locate with "X" in section below: Sketch map: 

6. Bore hole dia. 8 in. Completion date 6-25-76 Well depth 100 ft.

7. Cable tool Rotary Driven Dug Hollow rod Jetted Bored Reverse rotary

8. Use: Domestic Public supply Industry Irrigation Air conditioning Stock Lawn Oil field water Other

9. Casing: Material PVC Height: Above Below Threading: Welded Surface 27 in. RMP: PVC Blue Weight 2.75 lbs./ft. Dia. 5 in. to 100 ft. depth Wall Thickness: inches or Dia. 5 in. to 100 ft. depth gage No. 1258

10. Screen: Manufacturer's name Panco Type PVC Dia. 5" Slot/gauze .025 Length 20 Set between 10 ft. and 30 ft. Gravel pack? Size range of material 0.30-0.60

11. Static water level: 1' ft. below land surface Date 6-25-76 mo./day/yr.

12. Pumping level below land surfaces: Air test 1 1/2 ft. after 1 1/2 hrs. pumping 1 1/2 g.p.m. Estimated maximum yield 1 1/2 g.p.m.

13. Water sample submitted: No Yes No Date 6-25-76 mo./day/yr.

14. Well head completion: Cap top Pitless adapter 24" inches above grade

15. Well grouted? With: Neat cement Bentonite Concrete Depth: From 0 ft. to 10 ft.

16. Nearest source of possible contamination: ft. 50 Direction S Type Pond Well disinfected upon completion? Yes No

17. Pump: Not installed Manufacturer's name _____ Model number _____ HP _____ Volts _____ Length of drop pipe _____ ft. capacity _____ g.p.m. Type: Submersible Turbine Jet Reciprocating Centrifugal Other

18. Elevation: 915 Ft. Topography: Hill Slope Upland Valley

19. Remarks: I will pour my own cement slab around the well Eugene Herring

20. Water well contractor's certification: This well was drilled under my jurisdiction and this report is true to the best of my knowledge and belief. Stanley Dehg Co Inc 182 Business name License No. Address RT 1 Holton, Ks Signed Dale Gibson Date 6-25-76 Authorized representative

Forward the white, blue and pink copies to the Department of Health and Environment

Form WWC-5

BK = 9046

V: 9146

T 9 R 17 S 22