

USE TYPEWRITER OR BALL POINT PEN-PRESS FIRMLY, PRINT CLEARLY.

Amerson 863-2012 phone

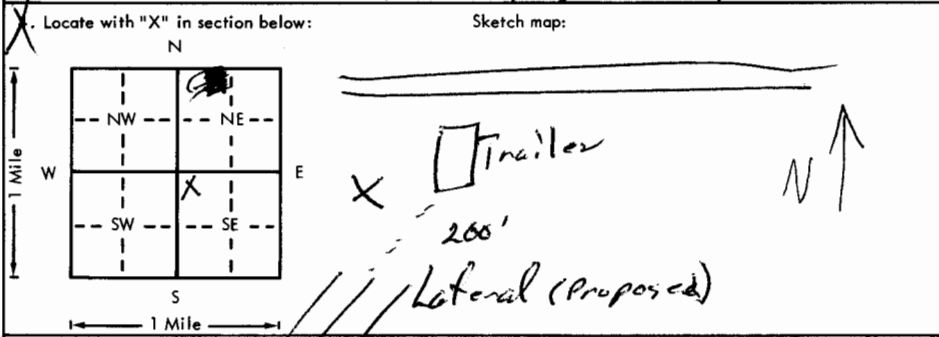
WATER WELL RECORD KSA 82a-1201-1215

dbb

Kansas Department of Health and Environment-Division of Environment (Water well Contractors) Topeka, Kansas 66620

1. Location of well: County Jefferson Fraction 1/4 NW 1/4, SW 1/4 SE 1/4 Section number 28 23 Township number T 9 S R 18 Range number 18 CBW

2. Distance and direction from nearest town or city: 2 mi. E, 1 mi N, Street address of well location if in city: 3/4 mi E, Ozawie 3. Owner of well: W. Amerson R.R. or street: 1631 Holt, K.C. Ka. 66107 City, state, zip code:

4. Locate with "X" in section below: Sketch map: 

6. Bore hole dia. 5 in. Completion date 6-26-76 Well depth 100 ft.

7. Cable tool Rotary Driven Dug Hollow rod Jetted Bored Reverse rotary

8. Use: Domestic Public supply Industry Irrigation Air conditioning Stock Lawn Oil field water Other

9. Casing: Material PVC Height: Above or below Threading Welded Surface 24 in. RMP PVC glue Weight 2.75 lbs./ft. Dia. 5 in. to 100 ft. depth Wall Thickness: inches or Dia. in. to ft. depth gage No. 1258

5. Type and color of material	From	To
<u>Red Sandy Clay</u>	<u>0</u>	<u>8</u>
<u>Brown Sand Stone</u>	<u>8</u>	<u>29</u>
<u>Gray Sand Stone</u>	<u>29</u>	<u>30</u>
<u>Soft Lime</u>	<u>30</u>	<u>34</u>
<u>Hard Lime</u>	<u>34</u>	<u>36</u>
<u>Shale</u>	<u>36</u>	<u>100</u>

10. Screen: Manufacturer's name Pumps Type PVC Dia. 5" Slot/gauze .025 Length 10 Set between 20 ft. and 30 ft. Gravel pack? Size range of material 030, 060

11. Static water level: 18 ft. below land surface Date 6-26-76 mo./day/yr.

12. Pumping level below land surfaces: Air Test ft. after hrs. pumping g.p.m. Estimated maximum yield 1/2 g.p.m.

13. Water sample submitted: No Date 6-26-76 mo./day/yr.

14. Well head completion: Cap Top 24 inches above grade Pitless adapter

15. Well grouted? With: Neat cement Bentonite Concrete Depth: From 0 ft. to 10 ft.

16. Nearest source of possible contamination: 100 ft. Direction SW Type Lateral Well disinfected upon completion? Yes No

17. Pump: Not installed Manufacturer's name _____ Model number _____ HP _____ Volts _____ Length of drop pipe _____ ft. capacity _____ g.p.m. Type: Submersible Turbine Jet Reciprocating Centrifugal Other

18. Elevation: 1030 ft Topography: Hill Slope Upland Valley

19. Remarks: I will Pour my own slab around the well.
W. Amerson

20. Water well contractor's certification: This well was drilled under my jurisdiction and this report is true to the best of my knowledge and belief. Business name Shader Drilling Co Inc License No. _____ Address RT 1 Holton, KS Signed Walter Robinson Date 6-28-76 Authorized representative

Forward the white, blue and pink copies to the Department of Health and Environment

Form WWC-5

SR-1022 8-10-72

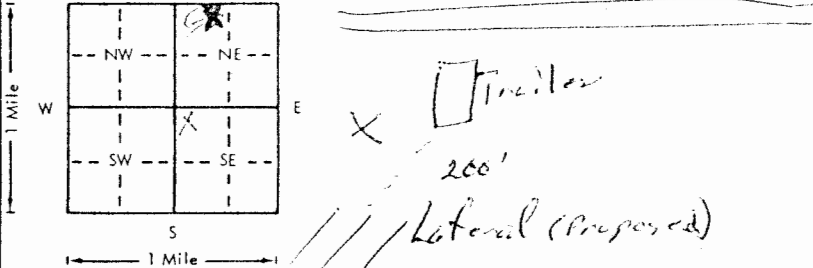
9-18E-28
1/4 1/4 1/4
N.W. 1/4 SE 1/4

USE TYPEWRITER OR BALL POINT PEN-PRESS FIRMLY, PRINT CLEARLY.

WATER WELL RECORD
KSA 82a-1201-1215

Kansas Department of Health and Environment-Division of Environment (Water well Contractors) Topeka, Kansas 66620

dbb

1. Location of well:		County <u>Jefferson</u>	Fraction <u>1/4 1/4 1/4 1/4 E 1/4</u>	Section number <u>23</u>	Township number <u>T 9 S</u>	Range number <u>R 15 E</u>
2. Distance and direction from nearest town or city: <u>2 mi. E, 1 mi. N,</u> Street address of well location if in city: <u>3/4 mi. E, Ozarkia</u>				3. Owner of well: <u>W. Amerson</u> R.R. or street: <u>1631 Holt, K.C. Ka. 66107</u> City, state, zip code:		
4. Locate with "X" in section below: Sketch map: 				6. Bore hole dia. <u>3</u> in. Completion date <u>6-26-76</u> Well depth <u>100</u> ft.		
5. Type and color of material				7. <input type="checkbox"/> Cable tool <input type="checkbox"/> Rotary <input checked="" type="checkbox"/> Driven <input type="checkbox"/> Dug <input type="checkbox"/> Hollow rod <input type="checkbox"/> Jetted <input type="checkbox"/> Bored <input type="checkbox"/> Reverse rotary		
Red Sandy Clay				8. Use: <input checked="" type="checkbox"/> Domestic <input type="checkbox"/> Public supply <input type="checkbox"/> Industry <input type="checkbox"/> Irrigation <input type="checkbox"/> Air conditioning <input type="checkbox"/> Stock <input type="checkbox"/> Lawn <input type="checkbox"/> Oil field water <input type="checkbox"/> Other		
Brown Sand Stone				9. Casing: Material <u>PVC</u> Height: Above or below Threaded <input type="checkbox"/> Welded <input type="checkbox"/> Surface <u>2.4</u> in. RMP <u>PVC</u> Weight <u>2.75</u> lbs./ft. Dia. <u>5</u> in. to <u>100</u> ft. depth Wall Thickness: inches or Dia. <u>5</u> in. to <u>100</u> ft. depth gage No. <u>1253</u>		
Gray Sand Stone				10. Screen: Manufacturer's name <u>Beampac</u> Type <u>PVC</u> Dia. <u>5"</u> Slot/gauze <u>1025</u> Length <u>10</u> Set between <u>20</u> ft. and <u>30</u> ft. ft. and <u>30</u> ft. Gravel pack? <input checked="" type="checkbox"/> Size range of material <u>30-60</u>		
Soft Line				11. Static water level: <u>18</u> ft. below land surface Date <u>6-26-76</u> mo./day/yr.		
Hard Line				12. Pumping level below land surfaces: <u>Rit test</u> ft. after <u> </u> hrs. pumping <u> </u> g.p.m. ft. after <u> </u> hrs. pumping <u> </u> g.p.m. Estimated maximum yield <u>1/2</u> g.p.m.		
Shale				13. Water sample submitted: <u> </u> mo./day/yr. <input type="checkbox"/> Yes <input checked="" type="checkbox"/> No Date <u> </u>		
				14. Well head completion: <u>Cap Top</u> <input type="checkbox"/> Pitless adapter <u>24</u> Inches above grade		
				15. Well grouted? <input checked="" type="checkbox"/> With: <input type="checkbox"/> Neat cement <input type="checkbox"/> Bentonite <input checked="" type="checkbox"/> Concrete Depth: From <u>0</u> ft. to <u>10</u> ft.		
				16. Nearest source of possible contamination: ft. <u>200</u> Direction <u>SW</u> Type <u>Lateral</u> Well disinfected upon completion? <input type="checkbox"/> Yes <input type="checkbox"/> No		
				17. Pump: <input checked="" type="checkbox"/> Not installed Manufacturer's name <u> </u> Model number <u> </u> HP <u> </u> Volts <u> </u> Length of drop pipe <u> </u> ft. capacity <u> </u> g.p.m. Type: <input type="checkbox"/> Submersible <input type="checkbox"/> Turbine <input type="checkbox"/> Jet <input type="checkbox"/> Reciprocating <input type="checkbox"/> Centrifugal <input type="checkbox"/> Other		
				(Use a second sheet if needed)		
18. Elevation: <u> </u> Topography: <input checked="" type="checkbox"/> Hill <input type="checkbox"/> Slope <input type="checkbox"/> Upland <input type="checkbox"/> Valley		19. Remarks: <u>I will pour my own slab</u> <u>around the well.</u> <u>W. Amerson</u>		20. Water well contractor's certification: This well was drilled under my jurisdiction and this report is true to the best of my knowledge and belief. <u> </u> Business name <u> </u> License No. <u> </u> Address <u>1631 Holt, K.C.</u> Signed <u> </u> Date <u>6-26-76</u> Authorized representative		

Forward the white, blue and pink copies to the Department of Health and Environment

Form WWC-5