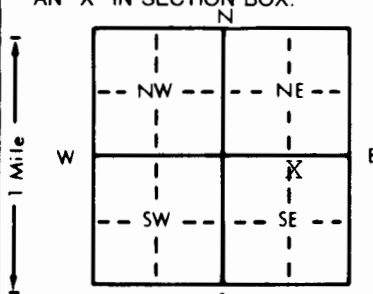


1 LOCATION OF WATER WELL: Fraction NW 1/4 NE 1/4 SE 1/4 Section Number 9 Township Number T 9 S Range Number R 19 **(EW)**
 County: JEFFERSON

Distance and direction from nearest town or city street address of well if located within city?
 4 north, 3/4 east of Oskaloosa

2 WATER WELL OWNER: Joe McAfee
 RR#, St. Address, Box #: 402 Delaware Board of Agriculture, Division of Water Resources
 City, State, ZIP Code: Oskaloosa, KS 66066 Application Number:

3 LOCATE WELL'S LOCATION WITH AN "X" IN SECTION BOX:  4 DEPTH OF COMPLETED WELL... 100' ft. ELEVATION: ...
 Depth(s) Groundwater Encountered 1... 37' ft. 2... ft. 3... ft.
 WELL'S STATIC WATER LEVEL... 27' ft. below land surface measured on mo/day/yr... 1-04-96
 Pump test data: Well water was ... ft. after ... hours pumping ... gpm
 Est. Yield... 2 gpm: Well water was ... ft. after ... hours pumping ... gpm
 Bore Hole Diameter... 10" in. to ... ft., and ... in. to ... ft.
 WELL WATER TO BE USED AS: 5 Public water supply 8 Air conditioning 11 Injection well
 1 Domestic 3 Feedlot 6 Oil field water supply 9 Dewatering 12 Other (Specify below)
 2 Irrigation 4 Industrial 7 Lawn and garden only 10 Monitoring well
 Was a chemical/bacteriological sample submitted to Department? Yes... No... **X**; If yes, mo/day/yr sample was submitted
 Water Well Disinfected? Yes **X** No

5 TYPE OF BLANK CASING USED: 5 Wrought iron 8 Concrete tile CASING JOINTS: Glued **X** Clamped
 1 Steel 3 RMP (SR) 6 Asbestos-Cement 9 Other (specify below) Welded
 2 PVC 4 ABS 7 Fiberglass Threaded
 Blank casing diameter... 5" in. to... 0-35... ft., Dia... 5" in. to... 75-98... ft., Dia... in. to... ft.
 Casing height above land surface... 24" in., weight... 2.82 lbs./ft. Wall thickness or gauge No... 258
 TYPE OF SCREEN OR PERFORATION MATERIAL: 7 PVC 10 Asbestos-cement
 1 Steel 3 Stainless steel 5 Fiberglass 8 RMP (SR) 11 Other (specify)
 2 Brass 4 Galvanized steel 6 Concrete tile 9 ABS 12 None used (open hole)
 SCREEN OR PERFORATION OPENINGS ARE: 5 Gauzed wrapped 8 Saw cut 11 None (open hole)
 1 Continuous slot 3 Mill slot 6 Wire wrapped 9 Drilled holes
 2 Louvered shutter 4 Key punched 7 Torch cut 10 Other (specify)
 SCREEN-PERFORATED INTERVALS: From... 35... ft. to... 75... ft., From... ft. to... ft.
 From... 98... ft. to... 100... ft., From... ft. to... ft.
 GRAVEL PACK INTERVALS: From... 24... ft. to... 100... ft., From... ft. to... ft.
 From... ft. to... ft., From... ft. to... ft.

6 GROUT MATERIAL: 1 Neat cement 2 Cement grout 3 Bentonite 4 Other
 Grout Intervals: From... 4... ft. to... 24... ft., From... ft. to... ft., From... ft. to... ft.
 What is the nearest source of possible contamination:
 1 Septic tank 4 Lateral lines 7 Pit privy 10 Livestock pens 14 Abandoned water well
 2 Sewer lines 5 Cess pool 8 Sewage lagoon 11 Fuel storage 15 Oil well/Gas well
 3 Watertight sewer lines 6 Seepage pit 9 Feedyard 12 Fertilizer storage 16 Other (specify below)
 13 Insecticide storage
 Direction from well? east How many feet? 420'

FROM	TO	LITHOLOGIC LOG	FROM	TO	PLUGGING INTERVALS
0	1	Top Soil			
1	26	Clay-Brown			
26	27	Fine Sand-Br			
27	35	Clay-Brown			
35	37	FS-CS-Med-Pea Gravel			
37	42	Clay-Blue			
42	44	Bldr-Loose			
44	47	Limestone-Y-Loose			
47	55	Shale-Yellow			
55	70	Limestone-Yellow			
70	75	Shale-Grey			
75	84	Limestone-Grey			
84	100	Shale-Grey			

7 CONTRACTOR'S OR LANDOWNER'S CERTIFICATION: This water well was (1) constructed, (2) reconstructed, or (3) plugged under my jurisdiction and was completed on (mo/day/year) 1-04-96 and this record is true to the best of my knowledge and belief. Kansas Water Well Contractor's License No. 182 This Water Well Record was completed on (mo/day/yr) 1-19-96 under the business name of STRADER DRILLING CO., INC. by (signature) Dale Soren