


1 LOCATION OF WATER WELL: Fraction  $\frac{1}{4}$  SE  $\frac{1}{4}$  SE  $\frac{1}{4}$  Section Number 16 Township Number T 9 S Range Number R 19 EW  
 County: Jefferson

Distance and direction from nearest town or city street address of well if located within city?  
 2 1/2 N 1 E of Oskaloosa, Ks.

2 WATER WELL OWNER: John Craven  
 RR#, St. Address, Box #: RR 2 Oskaloosa, Ks 66066  
 City, State, ZIP Code: RR 2 Oskaloosa, Ks 66066  
 Board of Agriculture, Division of Water Resources  
 Application Number:

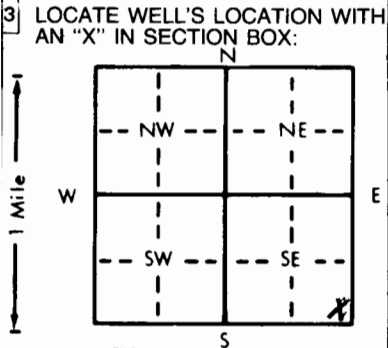

4 DEPTH OF COMPLETED WELL: 35 ft. ELEVATION:  
 Depth(s) Groundwater Encountered 1. 12' ft. 2. 34' ft. 3. .ft.  
 WELL'S STATIC WATER LEVEL: 12 ft. below land surface measured on mo/day/yr 9-13-83  
 Pump test data: Well water was .ft. after .hours pumping .gpm  
 Est. Yield: 20 gpm; Well water was .ft. after .hours pumping .gpm  
 Bore Hole Diameter: 8" in. to 35 .ft., and .in. to .ft.  
 WELL WATER TO BE USED AS:  
 1 Domestic (circled) 3 Feedlot 6 Oil field water supply 9 Dewatering 12 Other (Specify below)  
 2 Irrigation 4 Industrial 7 Lawn and garden only 10 Observation well  
 Was a chemical/bacteriological sample submitted to Department? Yes.....No...X.....; If yes, mo/day/yr sample was submitted  
 Water Well Disinfected? Yes X No

5 TYPE OF BLANK CASING USED:  
 1 Steel 2 PVC 3 RMP (SR) (circled) 4 ABS 5 Wrought iron 6 Asbestos-Cement 7 Fiberglass 8 Concrete tile 9 Other (specify below)  
 Blank casing diameter: 5 in. to 12' ft., Dia. .in. to .ft., Dia. .in. to .ft.  
 Casing height above land surface: 24" in., weight .lbs./ft. Wall thickness or gauge No. SDR 26  
 TYPE OF SCREEN OR PERFORATION MATERIAL:  
 1 Steel 2 Brass 3 Stainless steel 4 Galvanized steel 5 Fiberglass 6 Concrete tile 7 PVC 8 RMP (SR) (circled) 9 ABS 10 Asbestos-cement 11 Other (specify) 12 None used (open hole)  
 SCREEN OR PERFORATION OPENINGS ARE:  
 1 Continuous slot 2 Louvered shutter 3 Mill slot 4 Key punched 5 Gauzed wrapped 6 Wire wrapped 7 Torch cut 8 Saw cut (circled) 9 Drilled holes 11 None (open hole) 10 Other (specify)  
 SCREEN-PERFORATED INTERVALS: From 12 ft. to 35 ft., From .ft. to .ft., From .ft. to .ft.  
 GRAVEL PACK INTERVALS: From 12 11 ft. to 35 ft., From .ft. to .ft., From .ft. to .ft.

6 GROUT MATERIAL: 1 Neat cement 2 Cement grout (circled) 3 Bentonite 4 Other  
 Grout Intervals: From 0 ft. to 11 ft., From .ft. to .ft., From .ft. to .ft.  
 What is the nearest source of possible contamination:  
 1 Septic tank (circled) 2 Sewer lines 3 Watertight sewer lines 4 Lateral lines 5 Cess pool 6 Seepage pit 7 Pit privy 8 Sewage lagoon 9 Feedyard 10 Livestock pens 11 Fuel storage 12 Fertilizer storage 13 Insecticide storage 14 Abandoned water well 15 Oil well/Gas well 16 Other (specify below)  
 Direction from well? West How many feet? 100+

FROM	TO	LITHOLOGIC LOG	FROM	TO	LITHOLOGIC LOG
0	3	Top Soil			
3	12	Loamy clay			
12	34	Soft clay (mud)			
34	35	Gravel, med coarse dirty			

7 CONTRACTOR'S OR LANDOWNER'S CERTIFICATION: This water well was (1) constructed, (2) reconstructed, or (3) plugged under my jurisdiction and was completed on (mo/day/year) 9-13-83 and this record is true to the best of my knowledge and belief. Kansas Water Well Contractor's License No. 316 This Water Well Record was completed on (mo/day/yr) 6-26-84 under the business name of Robison Drilling by (signature) Jack Robison  
 INSTRUCTIONS: Use typewriter or ball point pen, PLEASE PRESS FIRMLY and PRINT clearly. Please fill in blanks, underline or circle the correct answers. Send top three copies to Kansas Department of Health and Environment, Division of Environment, Environmental Geology Section, Topeka, KS 66620. Send one to WATER WELL OWNER and retain one for your records.