

WATER WELL RECORD

Form WWC-5


Division of Water Resources App. No.

1 LOCATION OF WATER WELL: County: Jefferson	Fraction SW ¼ NW ¼ NE ¼ SE ¼	Section Number 32	Township No. T 9 S	Range Number R 19 <input checked="" type="checkbox"/> E <input type="checkbox"/> W
---	---------------------------------	----------------------	-----------------------	---

Street/Rural Address of Well Location; if unknown, distance & direction from nearest town or intersection: If at owner's address, check here .
200' north approx. of USD 341 District Office

Global Positioning System (GPS) information:
Latitude: .39.22225..... (in decimal degrees)
Longitude: -95.315194..... (in decimal degrees)
Elevation:
Datum: WGS 84, NAD 83, NAD 27
Collection Method:
 GPS unit (Make/Model:)
 Digital Map/Photo, Topographic Map, Land Survey
Est. Accuracy: <3 m, 3-5 m, 5-15 m, >15 m

2 WATER WELL OWNER: USD 341
RR#, Street Address, Box #: 404 Park Street
City, State, ZIP Code : Oskaloosa, KS *66066*

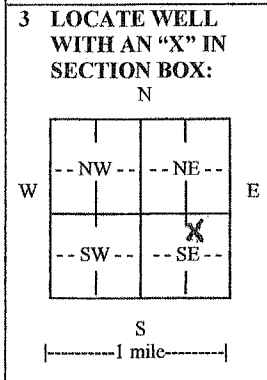

4 DEPTH OF COMPLETED WELL 61.5..... ft.

Depth(s) Groundwater Encountered (1)..... ft. (2)..... ft. (3)..... ft.
WELL'S STATIC WATER LEVEL 10.5..... ft. below land surface measured on mo/day/yr. 11/23/12.....

Pump test data: Well water was.....ft. after..... hours pumping..... gpm
EST. YIELD 5.....gpm. Well water was.....ft. after..... hours pumping..... gpm
Bore Hole Diameter 8 3/4.....in. to 61.5.....ft., and.....in. to.....ft.

WELL WATER TO BE USED AS: Public water supply Geothermal Injection well
 Domestic Feedlot Oil field water supply Dewatering Other (Specify below)
 Irrigation Industrial Domestic-lawn & garden Monitoring well

Was a chemical/bacteriological sample submitted to Department? Yes No
If yes, mo/day/yr sample was submitted.....
Water well disinfected? Yes No

5 TYPE OF CASING USED: Steel PVC Other

CASING JOINTS: Glued Clamped Welded Threaded
Casing diameter .5..... in. to .61.5..... ft., Diameter..... in. to..... ft., Diameter..... in. to..... ft.
Casing height above land surface 30..... in., Weight.....lbs./ft., Wall thickness or gauge No. SCH 40.....

TYPE OF SCREEN OR PERFORATION MATERIAL:
 Steel Stainless Steel PVC Other (Specify)
 Brass Galvanized Steel None used (open hole)

SCREEN OR PERFORATION OPENINGS ARE:
 Continuous slot Mill slot Gauze wrapped Torch cut Drilled holes None (open hole)
 Louvered shutter Key punched Wire wrapped Saw cut Other (specify)

SCREEN-PERFORATED INTERVALS: From 26.5..... ft. to 31.5..... ft., From 51.5..... ft. to 61.5..... ft.
From..... ft. to..... ft., From..... ft. to..... ft.

GRAVEL PACK INTERVALS: From 24..... ft. to 61.5..... ft., From..... ft. to..... ft.
From..... ft. to..... ft., From..... ft. to..... ft.

6 GROUT MATERIAL: Neat cement Cement grout Bentonite Other

Grout Intervals: From 2..... ft. to 24..... ft., From..... ft. to..... ft., From..... ft. to..... ft.

What is the nearest source of possible contamination:
 Septic tank Lateral lines Pit privy Livestock pens Insecticide storage Other (specify below)
 Sewer lines Cesspool Sewage lagoon Fuel storage Abandoned water well
 Watertight sewer lines Seepage pit Feedyard Fertilizer storage Oil well/gas well Storm Drain

Direction from well Southeast..... Distance from well 66'.....

FROM	TO	LITHOLOGIC LOG	FROM	TO	LITHO. LOG (cont.) or PLUGGING INTERVALS
0	5	Brown Clay	39	49	Yellow Silt and Brown Sandstone
5	16	Sandy Yellow Brown Clay	49	58	Brown Limestone
16	22	Grey Clay	58	59	Grey Shale
22	23	Grey Black Silty Clay w/organics	59	61	Black Shale
23	31	Sandy Grey Clay	61	63.5	Grey Limestone
31	32	Silt and Very Fine Grey Sand	63.5	70	Grey Shale
32	32.5	Grey Sandstone	70	73	Grey Limestone
32	36	Grey Clay	73	79	Grey Shale
36	37	Sandy Grey Clay			
37	39	Grey Clay			

7 CONTRACTOR'S OR LANDOWNER'S CERTIFICATION: This water well was constructed, reconstructed, or plugged under my jurisdiction and was completed on (mo/day/year) 11/23/2012..... and this record is true to the best of my knowledge and belief. Kansas Water Well Contractor's License No. 737..... This Water Well Record was completed on (mo/day/year) 12/2/2012..... under the business name of Rork Drilling..... by (signature) Mike Rork.....

INSTRUCTIONS: Use typewriter or ball point pen. PLEASE PRESS FIRMLY and PRINT clearly. Please fill in blanks and check the correct answers. Send three copies (white, blue, pink) to Kansas Department of Health and Environment, Bureau of Water, Geology Section, 1000 SW Jackson St., Suite 420, Topeka, Kansas 66612-1367. Telephone 785-296-5524. Send one copy to WATER WELL OWNER and retain one for your records. Include fee of \$5.00 for each constructed well. Visit us at <http://www.kdheks.gov/waterwell/index.html>.