


CORRECTED

1 LOCATION OF WATER WELL: County: Jefferson Fraction SW 1/4 SW 1/4 SW 1/4 SW 1/4 Section Number 33 Township Number T 9 S Range Number R 19 E W

2 WELL OWNER: Last Name: Edmonds First: Street or Rural Address where well is located (if unknown, distance and direction from nearest town or intersection): If at owner's address, check here:
 Business: Walnut Street Station
 Address: 816 Cherokee St.
 Address: 503 Walnut St., Oskaloosa, KS
 City: Oskaloosa State: KS ZIP: 66066

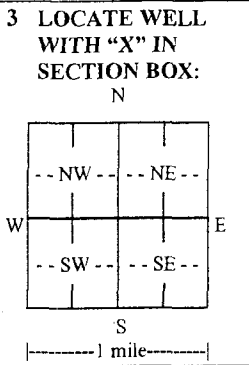

4 DEPTH OF COMPLETED WELL: 24.99 ft.
 Depth(s) Groundwater Encountered: 1) ft.
 2) ft. 3) ft., or 4) Dry Well
 WELL'S STATIC WATER LEVEL: 4.65 ft.
 below land surface, measured on (mo-day-yr) 7/16/15
 above land surface, measured on (mo-day-yr)
 Pump test data: Well water was ft. after hours pumping gpm
 Well water was ft. after hours pumping gpm
 Estimated Yield: gpm
 Bore Hole Diameter: 7.25 in. to ft. and in. to ft.

5 Latitude: 39.21616 (decimal degrees)
Longitude: 94.31038 (decimal degrees)
 Horizontal Datum: WGS 84 NAD 83 NAD 27
 Source for Latitude/Longitude:
 GPS (unit make/model:) (WAAS enabled? Yes No)
 Land Survey Topographic Map
 Online Mapper:

6 Elevation: 1100.76 ft. Ground Level TOC
 Source: Land Survey GPS Topographic Map
 Other

7 WELL WATER TO BE USED AS:

1. Domestic: Household Lawn & Garden Livestock
 Irrigation
 Feedlot
 Industrial

2. Public Water Supply: well ID
 Dewatering: how many wells?
 Aquifer Recharge: well ID
 Monitoring: well ID WMW3
 Environmental Remediation: well ID
 Air Sparge Soil Vapor Extraction
 Recovery Injection

10. Oil Field Water Supply: lease
 11. Test Hole: well ID
 Cased Uncased Geotechnical
 12. Geothermal: how many bores?
 a) Closed Loop Horizontal Vertical
 b) Open Loop Surface Discharge Inj. of Water
 13. Other (specify):

Was a chemical/bacteriological sample submitted to KDHE? Yes No If yes, date sample was submitted:
 Water well disinfected? Yes No

8 TYPE OF CASING USED: Steel PVC Other CASING JOINTS: Glued Clamped Welded Threaded
 Casing diameter 2 in. to 4.99 ft., Diameter in. to ft., Diameter in. to ft.
 Casing height above land surface -0.38 in. Weight lbs./ft. Wall thickness or gauge No.
 TYPE OF SCREEN OR PERFORATION MATERIAL:
 Steel Stainless Steel Fiberglass PVC Other (Specify) CORRECTED
 Brass Galvanized Steel Concrete tile None used (open hole)

SCREEN OR PERFORATION OPENINGS ARE:
 Continuous Slot Mill Slot Gauze Wrapped Torch Cut Drilled Holes Other (Specify)
 Louvered Shutter Key Punched Wire Wrapped Saw Cut None (Open Hole)

SCREEN-PERFORATED INTERVALS: From 4.99 ft. to 24.99 ft., From ft. to ft., From ft. to ft.
 GRAVEL PACK INTERVALS: From 3 ft. to 25.32 ft., From ft. to ft., From ft. to ft.

9 GROUT MATERIAL: Neat cement Cement grout Bentonite Other Concrete, 0-1"
 Grout Intervals: From 1 ft. to 3 ft., From ft. to ft., From ft. to ft.

Nearest source of possible contamination:
 Septic Tank Lateral Lines Pit Privy Livestock Pens Insecticide Storage
 Sewer Lines Cess Pool Sewage Lagoon Fuel Storage Abandoned Water Well
 Watertight Sewer Lines Seepage Pit Feedyard Fertilizer Storage Oil Well/Gas Well
 Other (Specify)

Direction from well? NW Distance from well? ~5'

10 FROM	TO	LITHOLOGIC LOG	FROM	TO	LITHO. LOG (cont.) or PLUGGING INTERVALS
0	0.3	Asphalt			
0.3	25.32	Greenish gray clay w/ caliche stringers			

Notes:
 KDHE Site: Walnut Street Station; U4-044-14690

11 CONTRACTOR'S OR LANDOWNER'S CERTIFICATION: This water well was constructed, reconstructed, or plugged under my jurisdiction and was completed on (mo-day-year) 7/13/15 and this record is true to the best of my knowledge and belief. Kansas Water Well Contractor's License No. 757. This Water Well Record was completed on (mo-day-year) 7/3/15 under the business name of Larsen & Associates. Signature

WATER WELL RECORD Form WWC-5


Original Record Correction Change in Well Use

Division of Water Resources App. No.

Well ID WMW3

1 LOCATION OF WATER WELL: County: Jefferson	Fraction SW ¼ SW ¼ SW ¼ SW ¼	Section Number 33	Township Number T 9 S	Range Number R 19 <input checked="" type="checkbox"/> E <input type="checkbox"/> W
---	---------------------------------	----------------------	--------------------------	---

2 WELL OWNER: Last Name: Edmonds Business: Walnut Street Station Address: 816 Cherokee St. Address: City: Oskaloosa State: KS ZIP: 66066	Street or Rural Address where well is located (if unknown, distance and direction from nearest town or intersection): If at owner's address, check here: <input type="checkbox"/> 503 Walnut St., Oskaloosa, KS
---	--

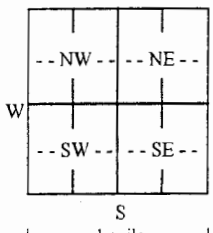3 LOCATE WELL WITH "X" IN SECTION BOX: N  S	4 DEPTH OF COMPLETED WELL: 24.99 ft. Depth(s) Groundwater Encountered: 1) ft. 2) ft. 3) ft. or 4) <input type="checkbox"/> Dry Well WELL'S STATIC WATER LEVEL: 4.65 ft. <input checked="" type="checkbox"/> below land surface, measured on (mo-day-yr) 7/16/15 <input type="checkbox"/> above land surface, measured on (mo-day-yr) Pump test data: Well water was ft. after hours pumping gpm Well water was ft. after hours pumping gpm Estimated Yield: gpm Bore Hole Diameter: 3.25 in. to ft. and in. to ft.	5 Latitude: 39.21616 (decimal degrees) Longitude: 94.31038 (decimal degrees) Horizontal Datum: <input checked="" type="checkbox"/> WGS 84 <input type="checkbox"/> NAD 83 <input type="checkbox"/> NAD 27 Source for Latitude/Longitude: <input type="checkbox"/> GPS (unit make/model: (WAAS enabled? <input type="checkbox"/> Yes <input type="checkbox"/> No) <input checked="" type="checkbox"/> Land Survey <input type="checkbox"/> Topographic Map <input type="checkbox"/> Online Mapper:
		6 Elevation: 1100.76 ft. <input type="checkbox"/> Ground Level <input checked="" type="checkbox"/> TOC Source: <input checked="" type="checkbox"/> Land Survey <input type="checkbox"/> GPS <input type="checkbox"/> Topographic Map <input type="checkbox"/> Other

7 WELL WATER TO BE USED AS:

1. Domestic: <input type="checkbox"/> Household <input type="checkbox"/> Lawn & Garden <input type="checkbox"/> Livestock 2. <input type="checkbox"/> Irrigation <input type="checkbox"/> Feedlot 3. <input type="checkbox"/> Industrial	4. <input type="checkbox"/> Public Water Supply: well ID 5. <input type="checkbox"/> Dewatering: how many wells? 6. <input type="checkbox"/> Aquifer Recharge: well ID 7. <input checked="" type="checkbox"/> Monitoring: well ID WMW3 8. Environmental Remediation: well ID <input type="checkbox"/> Air Sparge <input type="checkbox"/> Soil Vapor Extraction <input type="checkbox"/> Recovery <input type="checkbox"/> Injection	9. <input type="checkbox"/> Oil Field Water Supply: lease 10. <input type="checkbox"/> Test Hole: well ID <input type="checkbox"/> Cased <input type="checkbox"/> Uncased <input type="checkbox"/> Geotechnical 11. Geothermal: how many bores? a) Closed Loop <input type="checkbox"/> Horizontal <input type="checkbox"/> Vertical b) Open Loop <input type="checkbox"/> Surface Discharge <input type="checkbox"/> Inj. of Water 12. <input type="checkbox"/> Other (specify):
--	--	---

Was a chemical/bacteriological sample submitted to KDHE? Yes No If yes, date sample was submitted:

Water well disinfected? Yes No

8 TYPE OF CASING USED: Steel PVC Other CASING JOINTS: Glued Clamped Welded Threaded
 Casing diameter 2 in. to 4.99 ft., Diameter in. to ft., Diameter in. to ft.
 Casing height above land surface -0.38 in. Weight lbs./ft. Wall thickness or gauge No.
TYPE OF SCREEN OR PERFORATION MATERIAL:
 Steel Stainless Steel Fiberglass PVC Other (Specify)
 Brass Galvanized Steel Concrete tile None used (open hole)
SCREEN OR PERFORATION OPENINGS ARE:
 Continuous Slot Mill Slot Gauze Wrapped Torch Cut Drilled Holes Other (Specify)
 Louvered Shutter Key Punched Wire Wrapped Saw Cut None (Open Hole)
SCREEN-PERFORATED INTERVALS: From 4.99 ft. to 24.99 ft., From ft. to ft., From ft. to ft.
GRAVEL PACK INTERVALS: From 3 ft. to 25.32 ft., From ft. to ft., From ft. to ft.

9 GROUT MATERIAL: Neat cement Cement grout Bentonite Other Concrete: 0-1'
 Grout Intervals: From 1 ft. to 3 ft., From ft. to ft., From ft. to ft.
Nearest source of possible contamination:
 Septic Tank Lateral Lines Pit Privy Livestock Pens Insecticide Storage
 Sewer Lines Cess Pool Sewage Lagoon Fuel Storage Abandoned Water Well
 Watertight Sewer Lines Seepage Pit Feedyard Fertilizer Storage Oil Well/Gas Well
 Other (Specify)
 Direction from well? NW Distance from well? 5' ft.

10 FROM	TO	LITHOLOGIC LOG	FROM	TO	LITHO. LOG (cont.) or PLUGGING INTERVALS
0	0.3	Asphalt			
0.3	25.32	Greenish gray clay w/ caliche stringers			
Notes: KDHE Site: Walnut Street Station; U4-044-14690					

11 CONTRACTOR'S OR LANDOWNER'S CERTIFICATION: This water well was constructed, reconstructed, or plugged under my jurisdiction and was completed on (mo-day-year) 7/13/15 and this record is true to the best of my knowledge and belief. Kansas Water Well Contractor's License No. 757. This Water Well Record was completed on (mo-day-year) 10/3/15 under the business name of Larsen & Associates Signature _____

Mail 1 white copy along with a fee of \$5.00 for each constructed well to: Kansas Department of Health and Environment, Bureau of Water, GWTS Section, 1000 SW Jackson St., Suite 420, Topeka, Kansas 66612-1367. Mail one to Water Well Owner and retain one for your records. Telephone 785-296-5524. Visit us at <http://www.kdheks.gov/waterwell/index.html> KSA 82a-1212

Revised 7/10/2015

DENNIS L HANDKE

1820 NW 59th Terrace
TOPEKA, KANSAS 66618
785-286-4047 Home
785-286-1990 Fax

Jessica Chapman
Larsen & Associates
1311 E. 25th Street, Suite B
Lawrence, Kansas, 66046

July 31, 2015

RE: Monitor Well Elevation Survey
503 Walnut St., Oskaloosa, Kansas

Proj. 15-00DD
Walnut Street Station
U4-044-14690

Bench Mark: Chised x on top of SW bolt of the SW sign base at West center of property.
Elev: 1101.40 North 91 West 5224 (from SE Cor. Sec. 33-9-19E)

MW-1	rim	1100.94	North	74	SW1/4,SW1/4,SW1/4,SW1/4
	top pipe	1100.54	West	5195	Lat= 39.21623 Long = 95.31048
MW-2	rim	1100.72	North	92	SW1/4,SW1/4,SW1/4,SW1/4
	top pipe	1100.40	West	5163	Lat= 39.21628 Long = 94.31037
MW-3	rim	1101.14	North	47	SW1/4,SW1/4,SW1/4,SW1/4
	top pipe	1100.76	West	5165	Lat= 39.21616 Long = 94.31038
MW-4	rim	1102.80	North	35	SW1/4,SW1/4,SW1/4,SW1/4
	top pipe	1102.56	West	5208	Lat= 39.21613 Long = 94.31053
MW-5	rim	1102.91	North	144	SE1/4,SE1/4,SE1/4,SE1/4 (Sec. 32-9-19)
	top pipe	1102.50	West	5385	Lat= 39.21642 Long = 95.31115
MW-6	rim	1098.20	North	142	SW1/4,SW1/4,SW1/4,SW1/4
	top pipe	1097.77	West	5204	Lat= 39.21642 Long = 94.31051
MW-7	rim	1094.02	North	165	SW1/4,SW1/4,SW1/4,SW1/4
	top pipe	1093.77	West	5072	Lat= 39.21648 Long = 94.31005
MW-8	rim	1095.73	North	83	SW1/4,SW1/4,SW1/4,SW1/4
	top pipe	1095.20	West	5084	Lat= 39.21626 Long = 94.31009
MW-9	rim	1094.40	North	215	SW1/4,SW1/4,SW1/4,SW1/4
	top pipe	1094.01	West	5181	Lat= 39.21662 Long = 94.31043

Lat & Long derived Oskaloosa 7.5' quad map. WGS84

Elevation established from NGS BM C123 Reset.

If you have any questions, please feel free to call me. Thank you for the opportunity to be of service to you.

