WATER WELL RECORD Form WWC-5

■ Original Record ☐ Correction ☐ Change in Well Use

Division of Water Resources App. No. _____ Well ID WMW-6R

1 LOCATION OF WATER WELL: County: Jefferson | Fraction: SW ¼ SW ¼ SW ¼ SW ¼ | Section Number: 33 | Township Number: T 9 S | Range Number: R 19 ■ E ☐ W

2 WELL OWNER: Last Name: First:
Business: KDHE
Address: 1000 SW Jackson St., Suite 410
Address:
City: Topeka State: KS ZIP: 66612

Street or Rural Address where well is located (if unknown, distance and direction from nearest town or intersection): If at owner's address, check here: ☐
409 Walnut Street, Oskaloosa

3 LOCATE WELL WITH "X" IN SECTION BOX: N / W / E / S; NW, NE, SW, SE; X in SW; |----------1 mile---------|

4 DEPTH OF COMPLETED WELL: 20.5 ft.
Depth(s) Groundwater Encountered: 1) 15.0 ft. 2) ..... ft. 3) ..... ft., or 4) ☐ Dry Well
WELL'S STATIC WATER LEVEL: NA ft.
☐ below land surface, measured on (mo-day-yr).....
☐ above land surface, measured on (mo-day-yr).....
Pump test data: Well water was ..... ft. after..... hours pumping ..... gpm
Well water was ..... ft. after..... hours pumping ..... gpm
Estimated Yield: ..... gpm
Bore Hole Diameter: 8.75 in. to 25.0 ft. and ..... in. to ..... ft.

5 Latitude: 39.216388 (decimal degrees)
Longitude: -95.310277 (decimal degrees)
Horizontal Datum: ■ WGS 84 ☐ NAD 83 ☐ NAD 27
Source for Latitude/Longitude:
☐ GPS (unit make/model: .....) (WAAS enabled? ☐ Yes ☐ No)
☐ Land Survey ☐ Topographic Map
■ Online Mapper: Google Earth

6 Elevation: NA ft. ☐ Ground Level ☐ TOC
Source: ☐ Land Survey ☐ GPS ☐ Topographic Map ☐ Other .....

7 WELL WATER TO BE USED AS:
1. Domestic: ☐ Household ☐ Lawn & Garden ☐ Livestock
2. ☐ Irrigation
3. ☐ Feedlot
4. ☐ Industrial
5. ☐ Public Water Supply: well ID .....
6. ☐ Dewatering: how many wells? .....
7. ☐ Aquifer Recharge: well ID .....
8. ■ Monitoring: well ID WMW-6R
9. Environmental Remediation: well ID ..... ☐ Air Sparge ☐ Soil Vapor Extraction ☐ Recovery ☐ Injection
10. ☐ Oil Field Water Supply: lease .....
11. Test Hole: well ID ..... ☐ Cased ☐ Uncased ☐ Geotechnical
12. Geothermal: how many bores? ..... a) Closed Loop ☐ Horizontal ☐ Vertical b) Open Loop ☐ Surface Discharge ☐ Inj. of Water
13. ☐ Other (specify): .....

Was a chemical/bacteriological sample submitted to KDHE? ☐ Yes ■ No If yes, date sample was submitted: .....
Water well disinfected? ☐ Yes ■ No

8 TYPE OF CASING USED: ☐ Steel ■ PVC ☐ Other ..... CASING JOINTS: ☐ Glued ☐ Clamped ☐ Welded ■ Threaded
Casing diameter 2 in. to 5 ft., Diameter ..... in. to ..... ft., Diameter ..... in. to ..... ft.
Casing height above land surface 0 in. Weight ..... lbs./ft. Wall thickness or gauge No. sch 40

TYPE OF SCREEN OR PERFORATION MATERIAL:
☐ Steel ☐ Stainless Steel ☐ Fiberglass ■ PVC ☐ Other (Specify) .....
☐ Brass ☐ Galvanized Steel ☐ Concrete tile ☐ None used (open hole)

SCREEN OR PERFORATION OPENINGS ARE:
☐ Continuous Slot ■ Mill Slot ☐ Gauze Wrapped ☐ Torch Cut ☐ Drilled Holes ☐ Other (Specify) .....
☐ Louvered Shutter ☐ Key Punched ☐ Wire Wrapped ☐ Saw Cut ☐ None (Open Hole)

SCREEN-PERFORATED INTERVALS: From 5 ft. to 25 ft., From ..... ft. to ..... ft., From ..... ft. to ..... ft.
GRAVEL PACK INTERVALS: From 3 ft. to 25 ft., From ..... ft. to ..... ft., From ..... ft. to ..... ft.

9 GROUT MATERIAL: ☐ Neat cement ☐ Cement grout ■ Bentonite ■ Other cement pad
Grout Intervals: From 1 ft. to 3 ft., From 0 ft. to 1 ft., From ..... ft. to ..... ft.

Nearest source of possible contamination:
☐ Septic Tank ☐ Lateral Lines ☐ Pit Privy ☐ Livestock Pens ☐ Insecticide Storage
☐ Sewer Lines ☐ Cess Pool ☐ Sewage Lagoon ☐ Fuel Storage ☐ Abandoned Water Well
☐ Watertight Sewer Lines ☐ Seepage Pit ☐ Feedyard ☐ Fertilizer Storage ☐ Oil Well/Gas Well
■ Other (Specify) contaminated site
Direction from well? ..... Distance from well? ..... ft.

10 FROM	TO	LITHOLOGIC LOG	FROM	TO	LITHO. LOG (cont.) or PLUGGING INTERVALS
0	5	Clay Backfill, brown, petroleum odor			
5	12	Gravel Backfill			
12	25	Silty Clay, light brown, moist			

Notes: KDHE # U4-044-1469

11 CONTRACTOR'S OR LANDOWNER'S CERTIFICATION: This water well was ■ constructed, ☐ reconstructed, or ☐ plugged under my jurisdiction and was completed on (mo-day-year) 9-13-2022 and this record is true to the best of my knowledge and belief. Kansas Water Well Contractor's License No. 604 This Water Well Record was completed on (mo-day-year) 10/17/22 under the business name of Environmental Priority Service, inc. Signature .....

Mail 1 white copy along with a fee of $5.00 for each constructed well to: Kansas Department of Health and Environment, Bureau of Water, GWTS Section, 1000 SW Jackson St., Suite 420, Topeka, Kansas 66612-1367. Mail one to Water Well Owner and retain one for your records. Telephone 785-296-5524.

Visit us at http://www.kdheks.gov/waterwell/index.html KSA 82a-1212 **Revised 7/10/2015**

Jefferson 33-9-19E

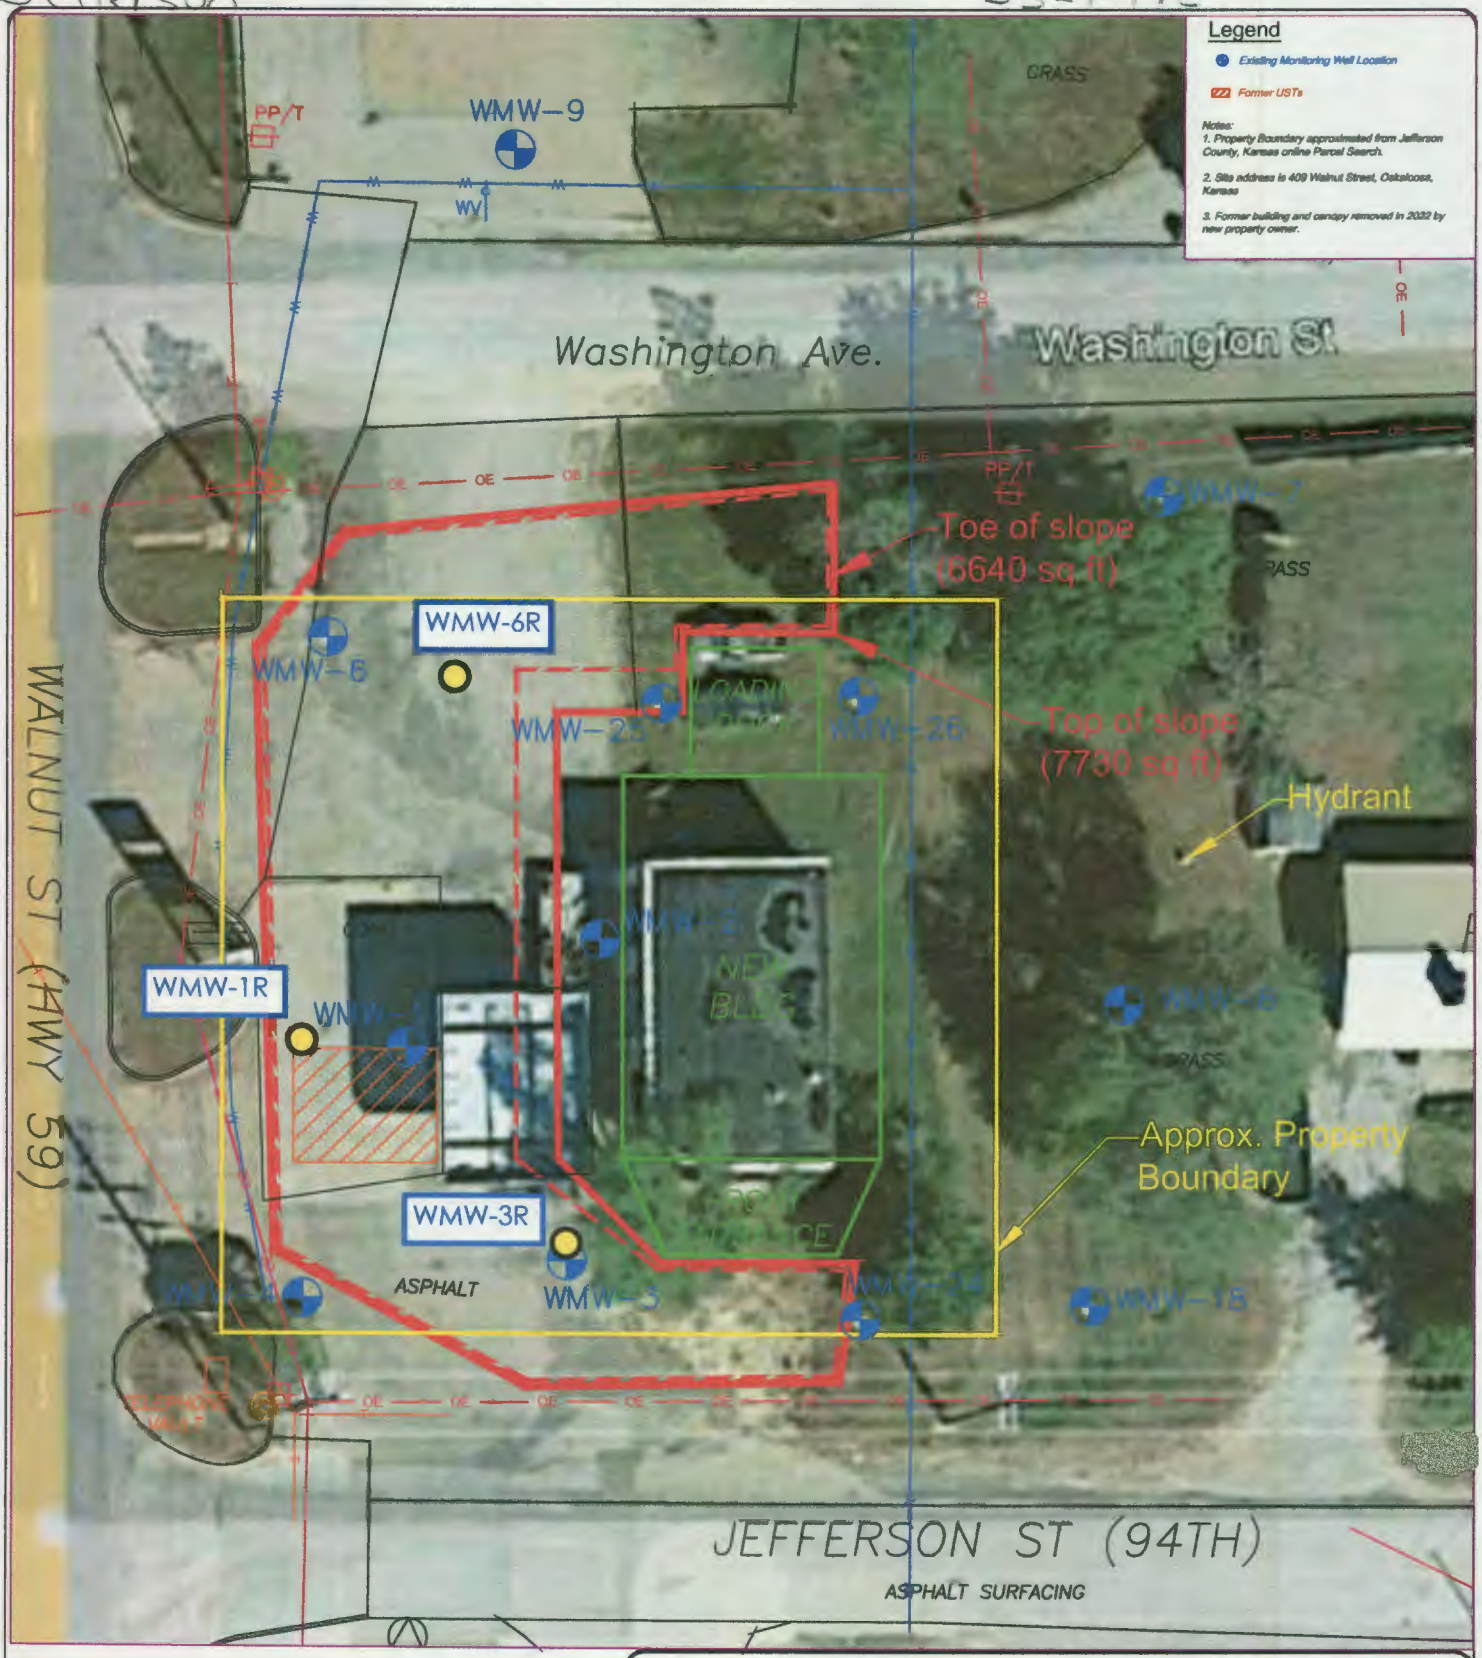

SCS ENGINEERS
ENVIRONMENTAL CONSULTANTS AND CONTRACTORS
8575 West 110th Street
Overland Park, Kansas 66210

FIGURE 3
SITE BASE MAP
Walnut Street Station
503 Walnut Street, Oskaloosa, Kansas

Project Mgr. SLM	Date 6/13/2022	KDHE Code: U4-044-14690	Proj No. 27218144.01
Scale:		File Name Oskaloosa RDP Drawings 042622.dwg	