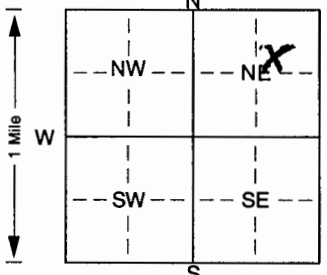


WELL 511

1 LOCATION OF WATER WELL: Fraction SW 1/4 NE 1/4 NE 1/4 Section Number 32 Township Number T 9 S Range Number R 2 E
 County: CLAY

Distance and direction from nearest town or city street address of well if located within city?
5 1/4 EAST AND 1 SOUTH OF OAK HILL

2 WATER WELL OWNER: ROY HENRY
 RR#, St. Address, Box #: 615 INDIAN RD Board of Agriculture, Division of Water Resources
 City, State, ZIP Code: LOWMOON, KS. 67458 Application Number: _____

3 LOCATE WELL'S LOCATION WITH AN "X" IN SECTION BOX:

 4 DEPTH OF COMPLETED WELL: 100 ft. ELEVATION: _____
 Depth(s) Groundwater Encountered 1. 81 ft. 2. _____ ft. 3. _____ ft.
 WELL'S STATIC WATER LEVEL: 6.7 ft. below land surface measured on mo/day/yr 9/15/03
 Pump test data: Well water was _____ ft. after _____ hours pumping _____ gpm
 Est. Yield 40-50 gpm: Well water was _____ ft. after _____ hours pumping _____ gpm
 Bore Hole Diameter: 9 in. to 100 ft., and _____ in. to _____ ft.
 WELL WATER TO BE USED AS:
 Domestic 3 Feedlot 6 Oil field water supply 9 Dewatering 12 Other (Specify below)
 2 Irrigation 4 Industrial 7 Domestic (lawn & garden) 10 Monitoring well
 Was a chemical/bacteriological sample submitted to Department? Yes _____ No ; If yes, mo/day/yr sample was submitted _____
 Water Well Disinfected? Yes No _____

5 TYPE OF BLANK CASING USED:
 1 Steel 3 RMP (SR) 6 Asbestos-Cement 9 Other (specify below) Welded _____
 2 PVC 4 ABS 7 Fiberglass _____ Threaded _____
 Blank casing diameter: 5 in. to 80 ft., Dia _____ in. to _____ ft., Dia _____ in. to _____ ft.
 Casing height above land surface: 24 in., weight _____ lbs./ft. Wall thickness or gauge No. SDR 26
 TYPE OF SCREEN OR PERFORATION MATERIAL:
 1 Steel 3 Stainless steel 5 Fiberglass 8 RMP (SR) 10 Asbestos-cement
 2 Brass 4 Galvanized steel 6 Concrete tile 9 ABS 11 Other (specify) _____
 12 None used (open hole)
 SCREEN OR PERFORATION OPENINGS ARE:
 1 Continuous slot Mill slot 5 Gauzed wrapped 8 Saw cut 11 None (open hole)
 2 Louvered shutter 4 Key punched 7 Torch cut 9 Drilled holes 10 Other (specify) _____ ft.
 SCREEN-PERFORATED INTERVALS: From 80 ft. to 100 ft., From _____ ft. to _____ ft.
 From _____ ft. to _____ ft., From _____ ft. to _____ ft.
 GRAVEL PACK INTERVALS: From 25 ft. to 100 ft., From _____ ft. to _____ ft.
 From _____ ft. to _____ ft., From _____ ft. to _____ ft.

6 GROUT MATERIAL: 1 Neat cement 2 Cement grout 3 Bentonite 4 Other _____
 Grout Intervals: From _____ ft. to _____ ft., From _____ ft. to _____ ft., From _____ ft. to _____ ft.
 What is the nearest source of possible contamination:
 1 Septic tank 4 Lateral lines 7 Pit privy 10 Livestock pens 14 Abandoned water well
 2 Sewer lines 5 Cess pool 8 Sewage lagoon 11 Fuel storage 15 Oil well/Gas well
 3 Watertight sewer lines 6 Seepage pit 9 Feedyard 12 Fertilizer storage 16 Other (specify below) _____
 Direction from well? SOUTH How many feet? 50

FROM	TO	LITHOLOGIC LOG	FROM	TO	PLUGGING INTERVALS
0	26	CLAY			
26	77	SHALE TAN WEATHERED			
77	81	SHALE GRAY			
81	83	LIMESTONE TAN H ₂ O			
83	90	LIME STONE GRANULAR W/ SHALE			
90	100	SHALE, GRAY			

7 CONTRACTOR'S OR LANDOWNER'S CERTIFICATION: This water well was (1) constructed, (2) reconstructed, or (3) plugged under my jurisdiction and was completed on (mo/day/year) 9/15/03 and this record is true to the best of my knowledge and belief. Kansas Water Well Contractor's Licence No. 585 This Water Well Record was completed on (mo/day/yr) 9/30/03 under the business name of ASSOCIATED PUMPING AND WELL INC by (signature) _____