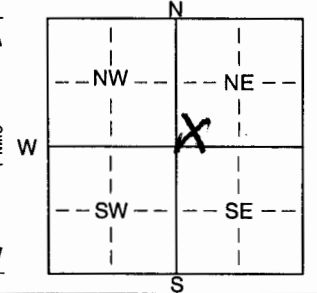


LOCATION OF WATER WELL: Fraction SW 1/4 SW 1/4 NE 1/4 Section Number 1B Township Number T 9 S Range Number R 2 E
 County: CLAY

Distance and direction from nearest town or city street address of well if located within city?
FROM IDAHO: 1.5 MILES EAST AND 5 MILES SOUTH

WATER WELL OWNER: DWIGHT KOCH
 RR#, St. Address, Box #: 840 12TH RD
 City, State, ZIP Code: CLAY CENTER, KS. 67432
 Board of Agriculture, Division of Water Resources
 Application Number: _____

LOCATE WELL'S LOCATION WITH AN "X" IN SECTION BOX:

 DEPTH OF COMPLETED WELL: 240 ft. ELEVATION: _____
 Depth(s) Groundwater Encountered 1. 76 ft. 2. _____ ft. 3. _____ ft.
 WELL'S STATIC WATER LEVEL _____ ft. below land surface measured on mo/day/yr _____
 Pump test data: Well water was _____ ft. after _____ hours pumping _____ gpm
 Est. Yield 1.0 gpm: Well water was _____ ft. after _____ hours pumping _____ gpm
 Bore Hole Diameter: 5.5 in. to 2.40 ft., and _____ in. to _____ ft.
 WELL WATER TO BE USED AS: 5 Public water supply 8 Air conditioning 11 Injection well
 1 Domestic 3 Feedlot 6 Oil field water supply 9 Dewatering 12 Other (Specify below)
 2 Irrigation 4 Industrial 7 Domestic (lawn & garden) 10 Monitoring well CLOSED LOOP PRODUCTION
 Was a chemical/bacteriological sample submitted to Department? Yes. _____ No. X; If yes, mo/day/yr sample was submitted
 Water Well Disinfected? Yes _____ No X

TYPE OF BLANK CASING USED:
 1 Steel 3 RMP (SR) 5 Wrought iron 8 Concrete tile CASING JOINTS: Glued _____ Clamped _____
 2 PVC 4 ABS 6 Asbestos-Cement Other (specify below) Welded
 7 Fiberglass HDRP Threaded _____
 Blank casing diameter 7/4 in. to 240 ft., Dia _____ in. to _____ ft., Dia _____ in. to _____ ft.
 Casing height above land surface 60 in., weight _____ lbs./ft. Wall thickness or gauge No. SR 11
 TYPE OF SCREEN OR PERFORATION MATERIAL:
 1 Steel 3 Stainless steel 5 Fiberglass 7 PVC 10 Asbestos-cement
 2 Brass 4 Galvanized steel 6 Concrete tile 8 RMP (SR) 11 Other (specify) _____
 12 None used (open hole)

SCREEN OR PERFORATION OPENINGS ARE:
 1 Continuous slot 3 Mill slot 5 Gauzed wrapped 8 Saw cut 11 None (open hole)
 2 Louvered shutter 4 Key punched 6 Wire wrapped 9 Drilled holes
 7 Torch cut 10 Other (specify) _____ ft.
 SCREEN-PERFORATED INTERVALS: From _____ ft. to _____ ft., From _____ ft. to _____ ft.
 From _____ ft. to _____ ft., From _____ ft. to _____ ft.
 GRAVEL PACK INTERVALS: From _____ ft. to _____ ft., From _____ ft. to _____ ft.
 From _____ ft. to _____ ft., From _____ ft. to _____ ft.

GROUT MATERIAL: 1 Neat cement 2 Cement grout Bentonite 4 Other _____
 Grout Intervals: From 5 ft. to 240 ft., From _____ ft. to _____ ft., From _____ ft. to _____ ft.
 What is the nearest source of possible contamination:
 1 Septic tank 4 Lateral lines 7 Pit privy 10 Livestock pens 14 Abandoned water well
 2 Sewer lines 5 Cess pool 8 Sewage lagoon 11 Fuel storage 15 Oil well/Gas well
 3 Watertight sewer lines 6 Seepage pit 9 Feedyard 12 Fertilizer storage 16 Other (specify below)
 13 Insecticide storage HOUSE
 Direction from well? EAST
 How many feet? 11

FROM	TO	LITHOLOGIC LOG	FROM	TO	PLUGGING INTERVALS
0	4	CLAY			
4	58	SHALE, BROWN TO GRAY TO RED			
58	62	LEWISTONIA			
62	76	SHALE, GRAY			5 HOURS
76	80	SANDSTONE H ₂ O			
80	101	SHALE, GRAY			
101	103	LEWISTONIA			3-230
103	144	SHALE, GRAY			1-240
144	147	LEWISTONIA			
147	202	SHALE, GRAY			
202	208	LEWISTONIA			1-220
208	240	SHALE, GRAY			

CONTRACTOR'S OR LANDOWNER'S CERTIFICATION: This water well was (1) constructed, (2) reconstructed, or (3) plugged under my jurisdiction and was completed on (mo/day/year) 5/24/04 and this record is true to the best of my knowledge and belief. Kansas Water Well Contractor's Licence No. 585. This Water Well Record was completed on (mo/day/yr) 6/24/04
 under the business name of ASSOCIATED LANDOWNERS INC by (signature) _____