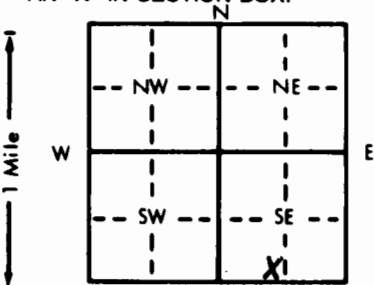


1 LOCATION OF WATER WELL: Fraction SE 1/4 SW 1/4 SE 1/4 Section Number 32 Township Number T 9 S Range Number R 20 E
 County: Jefferson

Distance and direction from nearest town or city street address of well if located within city?
1 N 3/8 E of McLouth

2 WATER WELL OWNER: Terry Troupe
 RR#, St. Address, Box #: RT. 1 Box 38 Board of Agriculture, Division of Water Resources
 City, State, ZIP Code: McLouth, KS 66054 Application Number:

3 LOCATE WELL'S LOCATION WITH AN "X" IN SECTION BOX:

 4 DEPTH OF COMPLETED WELL: 80' ft. ELEVATION:
 Depth(s) Groundwater Encountered 1. 15' ft. 2. _____ ft. 3. _____ ft.
 WELL'S STATIC WATER LEVEL 15' ft. below land surface measured on mo/day/yr 10-16-86
 Pump test data: Well water was _____ ft. after _____ hours pumping _____ gpm
 Est. Yield 1.7/2 gpm: Well water was _____ ft. after _____ hours pumping _____ gpm
 Bore Hole Diameter .8 in. to _____ ft., and _____ in. to _____ ft.
 WELL WATER TO BE USED AS: 5 Public water supply 8 Air conditioning 11 Injection well
1 Domestic 3 Feedlot 6 Oil field water supply 9 Dewatering 12 Other (Specify below)
2 Irrigation 4 Industrial 7 Lawn and garden only 10 Observation well
 Was a chemical/bacteriological sample submitted to Department? Yes _____ No X If yes, mo/day/yr sample was sub-
 mitted _____ Water Well Disinfected? Yes X No _____

5 TYPE OF BLANK CASING USED:
 1 Steel 3 RMP (SR) 5 Wrought iron 8 Concrete tile CASING JOINTS: Glued XX Clamped _____
 2 PVC 4 ABS 6 Asbestos-Cement 9 Other (specify below) Welded _____
 7 Fiberglass Threaded _____
 Blank casing diameter 5 in. to 0-14 ft., Dia 5 in. to 24-59 ft., Dia 5 in. to 60-80 ft.
 Casing height above land surface 24 in., weight 2,82 lbs./ft. Wall thickness or gauge No. 258
 TYPE OF SCREEN OR PERFORATION MATERIAL:
 1 Steel 3 Stainless steel 5 Fiberglass 7 PVC 10 Asbestos-cement
 2 Brass 4 Galvanized steel 6 Concrete tile 8 RMP (SR) 11 Other (specify) _____
 9 ABS 12 None used (open hole)
 SCREEN OR PERFORATION OPENINGS ARE:
 1 Continuous slot 5 Gauzed wrapped 8 Saw cut 11 None (open hole)
 2 Louvered shutter 3 Mill slot 6 Wire wrapped 9 Drilled holes
 4 Key punched 7 Torch cut 10 Other (specify) _____
 SCREEN-PERFORATED INTERVALS: From 14 ft. to 24 ft., From _____ ft. to _____ ft.
 From 59 ft. to 60 ft., From _____ ft. to _____ ft.
 GRAVEL PACK INTERVALS: From 10 ft. to 80 ft., From _____ ft. to _____ ft.
 From _____ ft. to _____ ft., From _____ ft. to _____ ft.

6 GROUT MATERIAL: 1 Neat cement 2 Cement grout 3 Bentonite 4 Other _____
 Grout Intervals: From 0 ft. to 10 ft., From _____ ft. to _____ ft., From _____ ft. to _____ ft.
 What is the nearest source of possible contamination:
 1 Septic tank 4 Lateral lines 7 Pit privy 10 Livestock pens 14 Abandoned water well
 2 Sewer lines 5 Cess pool 8 Sewage lagoon 11 Fuel storage 15 Oil well/Gas well
 3 Watertight sewer lines 6 Seepage pit 9 Feedyard 12 Fertilizer storage 16 Other (specify below)
 13 Insecticide storage _____
 Direction from well? SW How many feet? 350

FROM	TO	LITHOLOGIC LOG	FROM	TO	LITHOLOGIC LOG
0	2	Top Soil			
2	15	Clay-Brown			
15	19	Limestone-Yellow			
19	39	Shale-Grey			
39	45	Limestone-Grey			
45	80	Shale-Grey			

7 CONTRACTOR'S OR LANDOWNER'S CERTIFICATION: This water well was (1) constructed, (2) reconstructed, or (3) plugged under my jurisdiction and was completed on (mo/day/year) 10-16-86 and this record is true to the best of my knowledge and belief. Kansas
 Water Well Contractor's License No. 182 This Water Well Record was completed on (mo/day/yr) 11-24-86
 under the business name of Strader Drilling Co., Inc. by (signature) Dale Askren