32

VBRT R

USE TYPEWRITER OR BALL POINT PEN-PRESS FIRMLY, PRINT CLEARLY

T	R	EW	sec	1/4	1/4	1/4	No.

WATER WELL RECORD
KSA 82a-1201-1215

Kansas State Dept. Of Health
(Water Well Contractors)
Forbes-Bldg. 740
Topeka, Kansas 66620

1 Location of well: County	Township name	Fraction	Section number	Town number	Range number
Leavenworth	Alexandria	SE ¼-SE¼-NE¼ S[redacted]	25	9S	20E

Distance and direction from nearest town or city: 1½ S.

Street address of well location in city: Springdale, Ks.

3 Owner of well: John Moses

Address: McClouth, Kansas

Locate with "X" in section below:

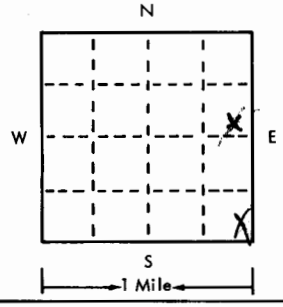

Sketch map:

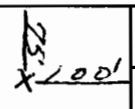

4 Well depth: 67 ft. Date of completion 9-3-75
Well diameter 10 in.

5 ☐ Cable tool ☒ Rotary ☐ Driven ☐ Dug
☐ Hollow rod ☐ Jetted ☐ Bored ☐ Reverse rotary

6 Use: ☒ Domestic ☐ Public supply ☐ Industry
☐ Irrigation ☐ Air conditioning ☐ Commercial
☐ Test well ☐

7 Casing: Material PVC Height: above/~~below~~
Threaded ☐ Welded ☐ Surface 24 in.
Diam. Weight 2.33 lbs./ft.
5 in. to 67 ft. depth Drive shoe? ☐ Yes ☒ No
___ in. to ___ ft. depth

2

Type and color of material	From	To
Top Soil	0	3
yellow Clay	3	54
Coarse sand	54	56
Pea gravel to ½"	56	61
Grey Shale	61	67

(use a second sheet if needed)

8 Screen:
Manufacturer Pumpco
Type PVC Dia. 5"
Slot/~~gauge~~ .025 Length 10'
Set between [redacted] ft. and [redacted] ft.
Fittings: 57'-67' .030-.080
Gravel pack ☒ Yes ☐ No Size range of material [redacted]

9 Static water level: NOT Measured
52 ft. below land surface Date 9-3-75 MNC

10 Pumping level below land surfaces: Air Test
___ ft. after ___ hrs. pumping ___ g.p.m.
___ ft. after ___ hrs. pumping ___ g.p.m.
Estimated maximum yield 40 g.p.m.

11 Water sample submitted:
☐ Yes ☒ No Date ___

12 Well head completion: Capped
☐ Pitless adapter 24 ☒ Inches above grade

13 Well grouted? ☐ Yes ☐ No
☐ Neat cement ☐ Bentonite ☐
Depth: From ___ ft. to ___ ft.

14 Nearest source of possible contamination:
ft. 125 Direction N Type S. Tank
Well disinfected upon completion? ☐ Yes ☐ No

15 Pump: ☒ Not installed
Manufacturer's name
Model number HP Volts
Length of drop pipe ft. capacity g.m.p.
Type:
☐ Submersible ☐ Turbine
☐ Jet ☐ Reciprocating
☐ Certrifugal ☐ Other

16 Remarks: elevation
907 V ¼ owner
Topography:
☐ [illegible]

this corner was in a dog's mouth the last time I saw it. KM

17 Water well contractor's certification:
This well was drilled under my jurisdiction and this report is true to the best of my knowledge and belief.
Strader Drlg. Co Fne 182
Business name License No.
Address RFD 1 Helton Ks
Signed [illegible] Date 9-5-75
Authorized representative

9 20E 25 SE SE NE

846

BR elev = 846 water elev = 855

Form WWC-5

677-H