

*CC Searles Jr.*  
 Not Home


Mr. B. Himpel

Contractor *KBR*  
 Tony  
 Bailey

### WATER WELL RECORD

#### DRILLERS LOG OF WELL

FROM (FT.)	TO (FT.)	KIND OF MATERIAL, COLOR, ETC. (NOTE WATER ZONES, AMOUNT, QUALITY)
0	3	Top Soil
3	18	Clay
18	28	Clay-Sand & Gravel
28	55	Drift
55	85	Shale
85	90	Sandy Shale

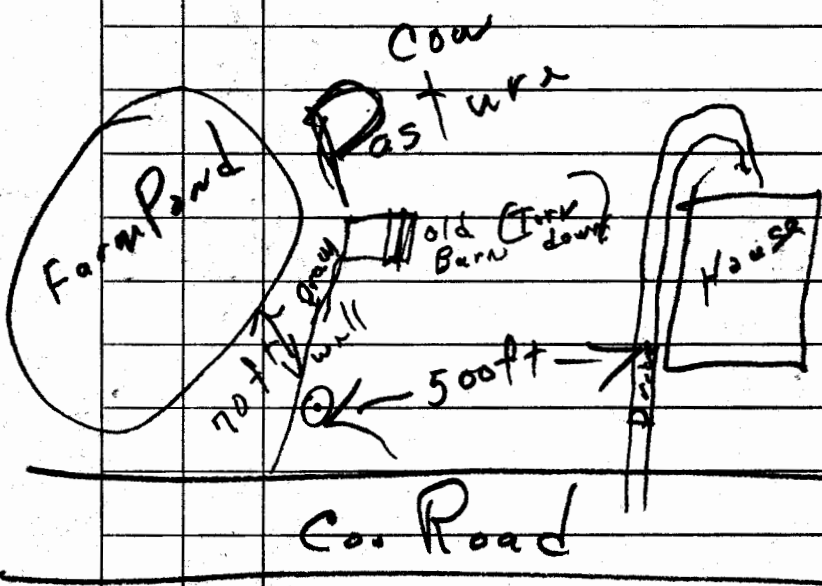

Well Owner *Seever at McLeuth*

Address McLeuth, Kansas

Drilling Contractor Breuer Drilling

Bascher, Kansas

Date Drilled Sept. 20 1971

Method of Drilling Cable Tools  
 (Cable tool, rotary, reverse rotary, etc.)

Casing Schedule 91 ft. New Galv. steel  
 (Amount, Size, Setting—New, Used—Steel, Galv.—Gage or Weight)

Screen Data (if any): \_\_\_\_\_  
 (Length, Diameter, Slot Size, Setting)

Measured depth to water on completed well (Static Level) is  
10 ft. below Land surface  
 (Land Surface, Top of Casing, Etc.)

TESTED YIELD: 1 gallons per Min  
 (Min., Hour)

as determined by Bailing  
 (Bailing, Test Pumping, Etc.)


DRAWDOWN: \_\_\_\_\_ ft. after \_\_\_\_\_ hrs.

pumping at \_\_\_\_\_ gal. per minute.

REMARKS:

*Located on Top of map*

LOCATION OF WELL Topographic Sheet Eston SW  
 [Show location in Section Plat] Elev. 1060±  
*58*

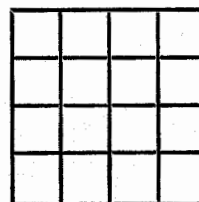

NE SE & NE & Sec. 21  
 T. 9 S., R. 20 E. W.  
 County Jefferson



Not to be used

KANSAS WELL SCHEDULE

Card 1

Record by Kleinsehmidt Date: 3-12-73 Project: Top-KC State: Kan K County: Jefferson 44

Latitude: \_\_\_\_\_ Longitude: \_\_\_\_\_ Accuracy: \_\_\_\_\_ Owner's well no: \_\_\_\_\_

Location: \_\_\_\_\_ NE no. sec 21 T. 9 N., R. 20 E. Well number: 920E21A

Owner: C C Seaples JR.

Owner: C C SEAPLES JR Altitude: \_\_\_\_\_ Accuracy 44

Driller: Brouer Date drilled: 9-20-71

Topography, well site: (D) Draw, flood plain, (F) lowland, (L) rolling, (S) slope, (T) terrace, (U) upland L Spring; or depth of well: 90 980 1

Diameter: 6 1/4 inches or feet 06 Depth cased: 90 90 Spring, or Csg. type: Steel 5 Finish: \_\_\_\_\_ Lift & power: elec-sub Q

Pump setting: \_\_\_\_\_ Use of well: Domestic stock, irrigation, industrial, public supply, observation, none, test 1

Water level: 10 above feet below 10 R 3 Water level records avail. \_\_\_\_\_

Description MP: \_\_\_\_\_

Yield: 10 gpm R 3 Pumping period: \_\_\_\_\_ Specific capacity: \_\_\_\_\_

Pumpage and other data available: \_\_\_\_\_

Card 2

Coefficient trans: \_\_\_\_\_ Coefficient storage: \_\_\_\_\_ Coefficient perm.: \_\_\_\_\_

Aquifer, system or series \_\_\_\_\_

Aquifer, units \_\_\_\_\_

Aquifer, thickness: \_\_\_\_\_ Aquifer, length of well open to: \_\_\_\_\_ Aquifer, depth to top of: \_\_\_\_\_ Aquifer, origin: \_\_\_\_\_

Aquifer, lithology of: \_\_\_\_\_

Bedrock, system: \_\_\_\_\_ Bedrock, formation: \_\_\_\_\_ Bedrock, depth to: \_\_\_\_\_

Surficial material: \_\_\_\_\_ Log data avail: Drillers log A

Quality of water data available: \_\_\_\_\_ Temperature of water: \_\_\_\_\_ Date sampled: \_\_\_\_\_

Coefficient of leakage: \_\_\_\_\_

THE FOLLOWING DATA ARE USED ON THE NATIONAL WELL SCHEDULE

Ownership category: (C) County, (F) Federal Gov't., (M) City, (N) Corp. or Co., (P) Private, (S) State Agency, (W) Water Dist. P

Method drilled: (A) Air, (B) bored, (C) cable, (D) dug, (V) driven, (H) hyd. rotary, (J) jetted, (R) rev. rotary, (T) trenching, (S) spring, C

Physiographic province: \_\_\_\_\_ Section: 04

Drainage basin: 016 Subbasin: \_\_\_\_\_ Depth to basement: \_\_\_\_\_ source of data (basement) \_\_\_\_\_

Quadrangle: \_\_\_\_\_

Well no. \_\_\_\_\_