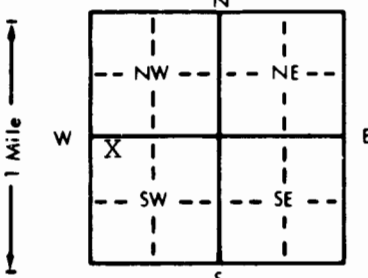


1 LOCATION OF WATER WELL: Fraction NW 1/4 NW 1/4 SW 1/4 Section Number 2 Township Number T 9 S Range Number R 20 E/W
 County: LEAVENWORTH

Distance and direction from nearest town or city street address of well if located within city?
 3 1/2 miles south, 2 1/2 west of Easton

2 WATER WELL OWNER: Carl Goff
 RR#, St. Address, Box # : P.O. Box 82 Board of Agriculture, Division of Water Resources
 City, State, ZIP Code : Easton, KS 66020 Application Number:

3 LOCATE WELL'S LOCATION WITH AN "X" IN SECTION BOX:

 4 DEPTH OF COMPLETED WELL: 140' ft. ELEVATION:
 Depth(s) Groundwater Encountered 1. 80' ft. 2. ft. 3. ft.
 WELL'S STATIC WATER LEVEL: 80' ft. below land surface measured on mo/day/yr 05/22/98
 Pump test data: Well water was ft. after hours pumping gpm
 Est. Yield 5 GPH: Well water was ft. after hours pumping gpm
 Bore Hole Diameter: 8 3/4 in. to ft., and in. to ft.
 WELL WATER TO BE USED AS:
 1 Domestic 3 Feedlot 6 Oil field water supply 9 Dewatering 12 Other (Specify below)
 2 Irrigation 4 Industrial 7 Lawn and garden only 10 Monitoring well
 Was a chemical/bacteriological sample submitted to Department? Yes No X; If yes, mo/day/yr sample was submitted
 Water Well Disinfected? Yes X No

5 TYPE OF BLANK CASING USED:
 1 Steel 3 RMP (SR) 5 Wrought iron 8 Concrete tile CASING JOINTS: Glued X Clamped
 2 PVC 4 ABS 6 Asbestos-Cement 9 Other (specify below) Welded
 7 Fiberglass Threaded
 Blank casing diameter 5" in. to 0-80 ft. Dia in. to ft. Dia in. to ft.
 Casing height above land surface 24" in. weight 2.82 lbs./ft. Wall thickness or gauge No. 258
 TYPE OF SCREEN OR PERFORATION MATERIAL:
 1 Steel 3 Stainless steel 5 Fiberglass 7 PVC 10 Asbestos-cement
 2 Brass 4 Galvanized steel 6 Concrete tile 8 RMP (SR) 11 Other (specify)
 12 None used (open hole)
 SCREEN OR PERFORATION OPENINGS ARE:
 1 Continuous slot 3 Mill slot 5 Gauzed wrapped 8 Saw cut 11 None (open hole)
 2 Louvered shutter 4 Key punched 6 Wire wrapped 9 Drilled holes
 7 Torch cut 10 Other (specify)
 SCREEN-PERFORATED INTERVALS: From 80 ft. to 140 ft. From ft. to ft.
 GRAVEL PACK INTERVALS: From 24 ft. to 140 ft. From ft. to ft.

6 GROUT MATERIAL: 1 Neat cement 2 Cement grout 3 Bentonite 4 Other
 Grout Intervals: From 4 ft. to 24 ft. From ft. to ft. From ft. to ft.
 What is the nearest source of possible contamination:
 1 Septic tank 4 Lateral lines 7 Pit privy 10 Livestock pens 14 Abandoned water well
 2 Sewer lines 5 Cess pool 8 Sewage lagoon 11 Fuel storage 15 Oil well/Gas well
 3 Watertight sewer lines 6 Seepage pit 9 Feedyard 12 Fertilizer storage 16 Other (specify below)
 13 Insecticide storage
 Direction from well? west How many feet? 200'

FROM	TO	LITHOLOGIC LOG	FROM	TO	PLUGGING INTERVALS
0	2	Clay-Brown	106	115	Limestone-Grey
2	16	Shale-Yellow	115	140	Shale-Grey
16	24	Shale-Grey			
24	28	Limestone-Grey			
28	37	Shale-Grey			
37	45	Sandstone-Grey			
45	51	Shale-Grey			
51	54	Sandstone-Grey			
54	55	Shale-Grey			
55	63	Limestone-Grey			
63	67	Shale-Grey			
67	87	Limestone-Grey			
87	91	Shale-Black			
91	94	Limestone-Grey			
94	106	Shale-Grey			

7 CONTRACTOR'S OR LANDOWNER'S CERTIFICATION: This water well was (1) constructed, (2) reconstructed, or (3) plugged under my jurisdiction and was completed on (mo/day/year) 05/22/98 and this record is true to the best of my knowledge and belief. Kansas Water Well Contractor's License No. 182 This Water Well Record was completed on (mo/day/yr) 6-3-98 under the business name of STRADER DRILLING CO., INC.. by (signature) Dale Skren