

KANSAS WELL SCHEDULE

Card 1

Record by Kleinschmidt Date: 4-18-77 Project: TOP-Kan State: Kan County: Leaw 52

Latitude: \_\_\_\_\_ Longitude: \_\_\_\_\_ Accuracy: \_\_\_\_\_ Owner's well no: \_\_\_\_\_

Location: SE 11 99 20 Well number: 920E 1BBD

Owner: Louis Domann Easton

Owner: LOUIS DOMANN Altitude: 985 985 Accuracy 3

Driller: Hand Dug Date drilled: \_\_\_\_\_

Topography, well site: (D) Draw, (F) flood plain, (L) lowland, (R) rolling, (S) slope, (T) terrace, (U) upland L Spring or depth of well: 30 30 3

Diameter: \_\_\_\_\_ Depth cased: \_\_\_\_\_ Spring, or Csg. type: \_\_\_\_\_ Finish: \_\_\_\_\_ Lift & power: 3

Pump setting: \_\_\_\_\_ Use of well: Domestic, stock, irrigation, industrial, public supply, observation, none, test 1

Water level: 7.9 above lsd 79 2 Water level records avail. \_\_\_\_\_

Description MP: 46 sq concrete slab with Pump on top 1.0 above lsd \_\_\_\_\_

Yield: \_\_\_\_\_ Pumping period: \_\_\_\_\_ Specific capacity: \_\_\_\_\_

Pumpage and other data available: \_\_\_\_\_

Card 2

Coefficient trans: \_\_\_\_\_ Coefficient storage: \_\_\_\_\_ Coefficient perm.: \_\_\_\_\_

Aquifer, system or series \_\_\_\_\_

Aquifer, units \_\_\_\_\_

Aquifer, thickness: \_\_\_\_\_ Aquifer, length of well open to: \_\_\_\_\_ Aquifer, depth to top of: \_\_\_\_\_ Aquifer, origin: \_\_\_\_\_

Aquifer, lithology of: \_\_\_\_\_

Bedrock, system: \_\_\_\_\_ Bedrock, formation: \_\_\_\_\_ Bedrock, depth to: \_\_\_\_\_

Surficial material: \_\_\_\_\_ Log data avail: No

Quality of water data available: \_\_\_\_\_ Temperature of water: \_\_\_\_\_ Date sampled: \_\_\_\_\_

Coefficient of leakage \_\_\_\_\_

THE FOLLOWING DATA ARE USED ON THE NATIONAL WELL SCHEDULE. Ownership category: \_\_\_\_\_ P

Method drilled: (A) Air, (B) bored, (C) cable, (D) dug, (V) driven, (H) hyd. rotary, (J) jetted, (R) rev. rotary, (T) trenching, (S) spring, \_\_\_\_\_ D



Physiographic province: \_\_\_\_\_ Section: \_\_\_\_\_

Drainage basin: \_\_\_\_\_ Subbasin: \_\_\_\_\_ Depth to basement: \_\_\_\_\_ source of data (basement) \_\_\_\_\_

Quadrangle \_\_\_\_\_ Well no. 9-20E-1BBD CF

25.0  
16.1  
8.9  
= 7.9

not

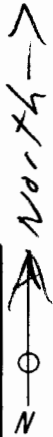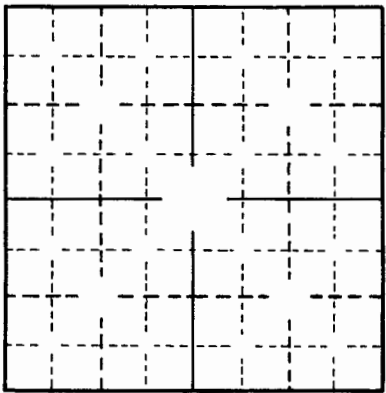

Co Road



Well

Well

