

KANSAS WELL SCHEDULE

Card 1

Not in computer file

Record by Kleeschmidt Date: 4-18-73 Project: Top-KC State: Kan County: Lea 52

Latitude: _____ Longitude: _____ Accuracy: _____ Owner's well no: _____

Location: SW NW NW no. sec. 14 T. 9 N., R. 20 E. Well number: 920E14BBC

Owner: Bob Courtney name address

Owner: BOB COURTNEY Altitude: 965 Accuracy 3

Driller: Hand Dug name address Date drilled: Dug

Topography, well site: (D) Draw, (F) flood plain, (L) lowland, (R) rolling, (S) slope, (T) terrace, (U) upland U Spring, or depth of well: 75 feet 35 accuracy 3

12.0
1.6
10.4

Diameter: 5 1/2 inches or feet 66 Depth cased: 35 feet 35 Spring, or Csg. type: Pick Finish: _____ Lift & power: elec 5 ft A

Pump setting: _____ Use of well: Domestic stock, irrigation, industrial, public supply, observation, none, test _____ 1

Water level: _____ above lsd _____ below _____ accuracy _____ date measured _____ Water level records avail. _____

Description MP: Hand Dug Top Casing 1.0 above 4' of concrete slab above lsd

Yield: _____ gpm _____ accuracy _____ Pumping period: _____ hours or days _____ Specific capacity: _____ gpm/ft. dd _____

Pumpage and other data available: _____ 80

Card 2

Coefficient trans: _____ gpd/ft _____ Coefficient storage: _____ Coefficient perm.: _____ gpd/ft²

Aquifer, system or series _____ Aquifer, units _____

Aquifer, thickness: _____ feet _____ Aquifer, length of well open to: _____ feet _____ Aquifer, depth to top of: _____ lsd _____ feet _____ Aquifer, origin: _____

Aquifer, lithology of: _____ Bedrock, system: _____ Bedrock, formation: _____ Bedrock, depth to: _____ lsd _____ feet _____

Surficial material: _____ lithology _____ infiltration characteristics _____ Log data avail: _____

Quality of water data available: _____ Temperature of water: _____ °F. _____ Date sampled: _____

Coefficient of leakage: _____

THE FOLLOWING DATA ARE USED ON THE NATIONAL WELL SCHEDULE
Ownership category: (C) County, (F) Federal Gov't., (M) City, (N) Corp. or Co., (P) Private, (S) State Agency, (W) Water Dist. P

Method drilled: (A) Air, (B) bored, (C) cable, (D) dug, (H) driven, (I) hyd. rotary, (J) jetted, (R) rev. rotary, (T) trenching, (S) spring, D

Physiographic province: _____ Section: _____

Drainage basin: _____ Subbasin: _____ Depth to basement: _____ source of data (basement) _____

Quadrangle _____
Well no. _____

pond

They were digging
Trench 4-18-73


Shed

Barn Trench Hoop

Shed

Co Road

North ←

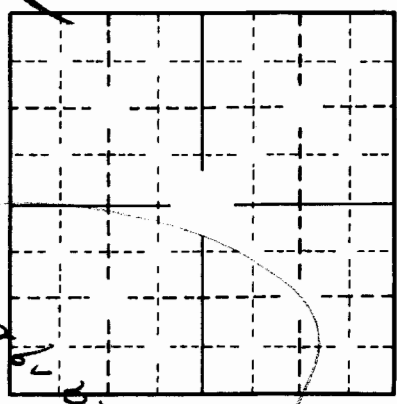

pond