

W 1/4 mito Coline

KANSAS WELL SCHEDULE
Card 1

Record by Kleinschmidt Date: 4-18-73 Project: Top-KC State: Kans County: Leau

Latitude: _____ Longitude: _____ Accuracy: _____ Owner's well no: _____

Location: _____ NW no. sec. 22 T. 9 N., R. 20 E. Well number: 920522B

Owner: Charles Courtney R#2 Milouth

Owner: CHARLES COURTNEY Altitude: _____ Accuracy _____

Driller: Hand dug Rock Date drilled: Hand dug 4-18-73

Topography, well site: (D) Draw, (F) flood plain, (L) lowland, (R) rolling, (S) slope, (T) terrace, (U) upland Spring or depth of well: 28 228 1

Diameter: 31 inches or feet Depth cased: _____ Spring, or Csg. type: _____ Finish: _____ Lift & power: _____

Pump setting: _____ Use of well: Domestic stock, irrigation, industrial, public supply, observation, none, test _____

Water level: _____ above _____ below _____ date measured 073 Water level records avail. _____

Description MP: Concrete Slab 4' square 0.5

Yield: _____ gpm Pumping period: _____ hours or days Specific capacity: _____ gpm/ft. dd

Pumpage and other data available: _____

Card 2

Coefficient trans: _____ gpd/ft Coefficient storage: _____ Coefficient perm.: _____ gpd/ft²

Aquifer, system or series _____

Aquifer, units _____

Aquifer, thickness: _____ feet Aquifer, length of well open to: _____ feet Aquifer, depth to top of: _____ feet Aquifer, origin: _____

Aquifer, lithology of: _____

Bedrock, system: _____ Bedrock, formation: _____ Bedrock, depth to: _____ feet

Surficial material: _____ lithology _____ infiltration characteristics _____ Log data avail: _____

Quality of water data available: _____ Temperature of water: _____ °F. Date sampled: _____

THE FOLLOWING DATA ARE USED ON THE NATIONAL WELL SCHEDULE
Ownership category: (C) County, (F) Federal Gov't., (M) City, (N) Corp. or Co., (P) Private, (S) State Agency, (W) Water Dist. P

Method drilled: (A) Air, (B) bored, (C) cable, (D) dug, (V) driven, (H) hyd. rotary, (J) jetted, (R) rev. rotary, (T) trenching, (S) spring, D

Physiographic province: _____ Section: _____

Drainage basin: _____ Subbasin: _____ Depth to basement: _____ source of data (basement) _____


Quadrangle _____
Well no. _____

5.0
1.7
3.13
3.3
2.7

2.7
3.13
at ground surface

4-18-73


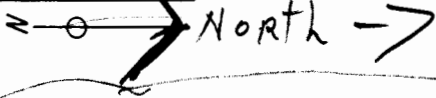

Shed

Bar

Shed

House

well
cistern

Duck

Highway 93