

215

check again

V.P.P.T

USE TYPEWRITER OR BALL POINT PEN-PRESS FIRMLY, PRINT CLEARLY.


WATER WELL RECORD  
KSA 82a-1201-1215

Kansas Department of Health and Environment-Division of Environment (Water well Contractors) Topeka, Kansas 66620

BDD?

1. Location of well:	County <b>Leavenworth</b>	Fraction <b>SW 1/4 SE 1/4 NW 1/4</b>	Section number <b>1</b>	Township number <b>T 9 S R 21</b>	Range number <b>EW</b>
----------------------	------------------------------	-----------------------------------------	----------------------------	--------------------------------------	---------------------------

2. Distance and direction from nearest town or city: Street address of well location if in city: <b>3 1/2 miles west of Leavenworth, Kansas</b>	3. Owner of well: <b>Mr. A. G. List</b> R.R. or street: <b>711 Maple Avenue</b> City, state, zip code: <b>Leavenworth, Kansas 66048</b>
---	---

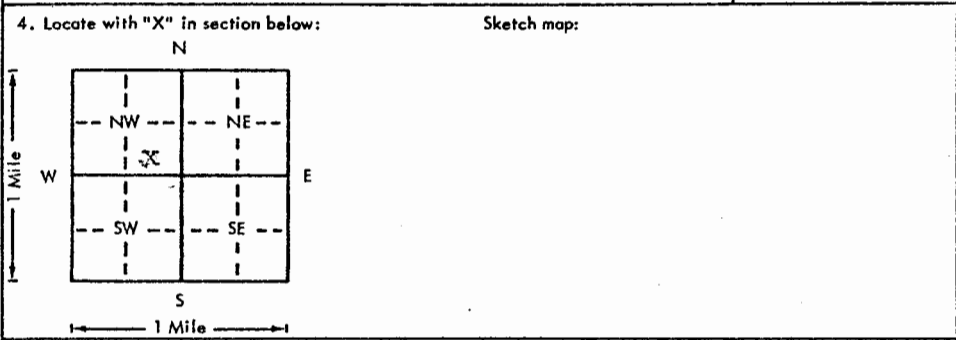

6. Bore hole dia. **8** in. Completion date **3-19-76**  
Well depth **140** ft.

7. Cable tool  Rotary  Driven  Dug  
 Hollow rod  Jetted  Bored  Reverse rotary

8. Use:  Domestic  Public supply  Industry  
 Irrigation  Air conditioning  Stock  
 Lawn  Oil field water  Other

9. Casing: Material **PT.** Height: Above or below  
Threaded  Welded  Surface  in.  
RMP  PVC  Weight  lbs./ft.  
Dia. **5** in. to **140** depth Wall Thickness: inches or  
Dia.  in. to  ft. depth gage No. **258 WT**

5. Type and color of material	From	To
Top Soil	0	4
Brown Clay	4	34
Coarse Sand	34	37
Grey Lime	37	50
Grey Shale	50	55
Grey Lime	55	110
Grey Shale	110	116
Grey Lime	116	133
Grey Shale	133	140

10. Screen: Manufacturer's name **Vinylplex, Inc.**  
Type **PVC** Dia.   
Slot/gauze **06 1/16** Length   
Set between **30** ft. and **40** ft.  
ft. and  ft.  
Gravel pack?  Size range of material **1/4 - 1/8**

11. Static water level:  mo./day/yr.  
**30** ft. below land surface Date **3-19-76**

12. Pumping level below land surfaces:  
 ft. after  hrs. pumping  g.p.m.  
 ft. after  hrs. pumping  g.p.m.  
Estimated maximum yield **2** g.p.m.

13. Water sample submitted:  mo./day/yr.  
Yes  No  Date

14. Well head completion:  
 Pitless adapter **18** inches above grade

15. Well grouted? **Yes**  
With:  Neat cement  Bentonite  Concrete  
Depth: From **3** ft. to **23** ft.

16. Nearest source of possible contamination:  
ft. **150** Direction **North** Type **Septic**  
Well disinfected upon completion?  Yes  No

17. Pump:  Not installed **NONE**  
Manufacturer's name **JACOBS**  
Model number **7777** HP **1/4** Volts **220**  
Length of drop pipe **197** ft. capacity **197** g.p.m.  
Type:  
 Submersible  Turbine  
 Jet  Reciprocating  
 Centrifugal  Other

(Use a second sheet if needed)

18. Elevation: **95**  
**1045**  
Topography:  
 Hill  
 Slope  
 Upland  
 Valley

19. Remarks:

20. Water well contractor's certification:  
This well was drilled under my jurisdiction and this report is true to the best of my knowledge and belief.  
**BREUER, INC.** **174**  
Business name License No.  
Address **Box 717 Hasehor, Ks.**  
Signed **[Signature]** Date **3/22/76**

Forward the white, blue and pink copies to the Department of Health and Environment

Form WWC-5

BR elev = 1008  
▽ = 1015 1065

CF