

USE TYPEWRITER OR BALL POINT PEN-PRESS FIRMLY, PRINT CLEARLY.

WATER WELL RECORD
KSA 82a-1201-1215


Kansas Department of Health and Environment-Division of Environment
(Water well Contractors)
Topeka, Kansas 66620

*marked well
A map
that know is
to this is
but not OK*

*new homes in
area but cant locate*

1. Location of well: County **Leavenworth** Fraction **SW 1/4 NE-1/4 NE 1/4** Section number **2** Township number **T 9 S R 21** Range number **EW**

2. Distance and direction from nearest town or city: **4 1/4 miles west of Leavenworth, Ks. on 92 Hwy.** Owner of well: **Geer Construction Company**
Street address of well location if in city: **7315 State** R.R. or street:
City, state, zip code: **Kansas City, Kansas 66112**

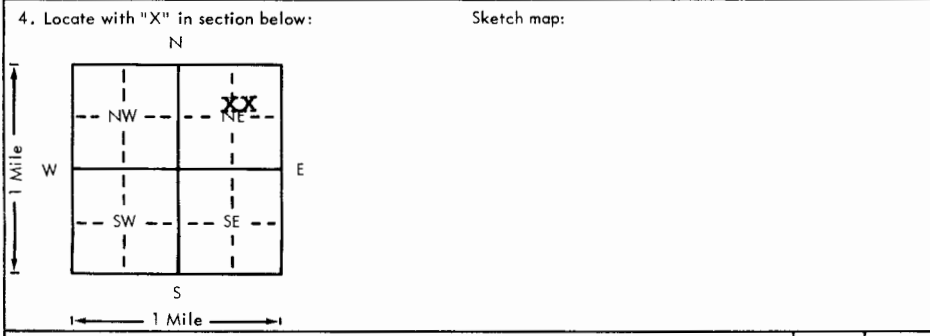

6. Bore hole dia. **8** in. Completion date **6-7-78**
Well depth **100** ft.

7. Cable tool Rotary Driven Dug
 Hollow rod Jetted Bored Reverse rotary

8. Use: Domestic Public supply Industry
 Irrigation Air conditioning Stock
 Lawn Oil field water Other

9. Casing: Material **PL** Height: Above or below
Threaded Welded Surface **18** in.
RMP PVC Weight lbs./ft.
Dia. **5** in. to **10 1/2** ft. depth Wall Thickness: inches or
Dia. in. to ft. depth gage No. **K 265**

5. Type and color of material	From	To
NO. 4		
Top Soil	0	1
Clay	1	12
Sandy Clay	12	17
Sand	17	22
Sand & Clay	22	37
Lime	37	40
Shale	40	66
Lime w/small broken shale	66	96
Shale	96	100
(Use a second sheet if needed)		

10. Screen: Manufacturer's name **(Slotted Pipe Vinylplex, Inc.)**

Type **PVC** Dia. **5"**
Slot/gauze **.06 1/16** Length **12'**
Set between **25** ft. and **37** ft.
Gravel pack? Size range of material **1/4 - 1/8**

11. Static water level: mo./day/yr.
6 ft. below land surface Date **6-7-78**

12. Pumping level below land surfaces:
____ ft. after ____ hrs. pumping ____ g.p.m.
____ ft. after ____ hrs. pumping ____ g.p.m.
Estimated maximum yield **4** g.p.m.

13. Water sample submitted: mo./day/yr.
 Yes No Date _____

14. Well head completion:
 Pitless adapter **18** Inches above grade

15. Well grouted? **Yes**
With: Neat cement Bentonite Concrete
Depth: From **3** ft. to **15** ft.

16. Nearest source of possible contamination:
ft. **450** Direction **NE** Type **Septic**
Well disinfected upon completion? Yes No

17. Pump: Not installed
Manufacturer's name **Jacuzzi**
Model number **5S4B** HP **1/2** Volts **220**
Length of drop pipe **90** ft. capacity **10** g.p.m.
Type:
 Submersible Turbine
 Jet Reciprocating
 Centrifugal Other

18. Elevation:
Topography:
 Hill
 Slope
 Upland
 Valley

19. Remarks:

20. Water well contractor's certification:
This well was drilled under my jurisdiction and this report is true to the best of my knowledge and belief.
BREUER, INC. **174**
Business name License No.
Address **Box 147, Basehor, Ks.**
Signed *[Signature]* Date **6-22**

Authorized Representative

T-9
R-210
W-2
Sec SW NE 1/4 1/4 1/4