287

VBRI

USE TYPEWRITER OR BALL POINT PEN-PRESS FIRMLY, PRINT CLEARLY.

T R EW sec 1/4 1/4 1/4 No.

WATER WELL RECORD
KSA 82a-1201-1215
NW-SW-SW

Kansas State Dept. Of Health
(Water Well Contractors)
Forbes-Bldg. 740
Topeka, Kansas 66620

1 Location of well:	County	Township name	Fraction	Section number	Town number	Range number
	Leavenworth		~~NW 1/4~~ ~~SE 1/4~~ SW 1/4	30	9	21

Distance and direction from nearest town or city: 1 3/4 S SPRINGDALE

Street address of well location if in city:

3 Owner of well: Gene Lawrence

Address: RR#1, McLouth, Ks. 66054

Locate with "X" in section below:

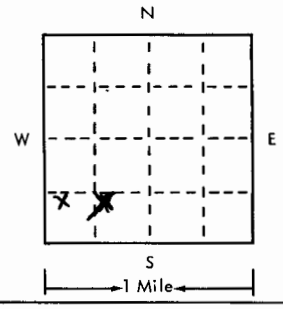

Sketch map:

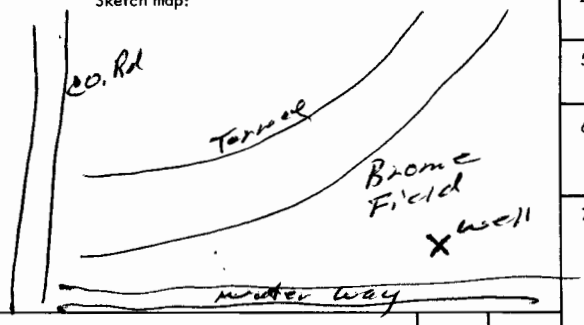

4 Well depth: 55 ft. Date of completion 5-21-79
Well diameter 10 in.

5 ☐ Cable tool ☒ Rotary ☐ Driven ☐ Dug ☐ Hollow rod ☐ Jetted ☐ Bored ☐ Reverse rotary

6 Use: ☒ Domestic ☐ Public supply ☐ Industry ☐ Irrigation ☐ Air conditioning ☐ Commercial ☐ Test well ☐

7 Casing: Material PVC Height: above/below Surface 24 in.
Threaded ☐ Welded ☐ Weight 2.74 lbs./ft.
Diam. 5 in. to 55 ft. depth Drive shoe? ☐ Yes ☐ No
in. to ft. depth

2

Type and color of material	From	To
Top Soil	0	5
Brown Clay	5	20
Blue Clay	20	33
Brown Sandy Gravel	33	40
Gray Shale	40	55
(use a second sheet if needed)		

8 Screen:
Manufacturer Pumpco
Type PVC Dia. 5"
Slot gauze .020 Length 20
Set between 35 ft. and 55 ft.
Fittings:
Gravel pack ☒ Yes ☐ No Size range of material .030

9 Static water level:
15 ft. below land surface Date 5-21-79

10 Pumping level below land surfaces: Air test
ft. after hrs. pumping g.p.m.
ft. after hrs. pumping g.p.m.
Estimated maximum yield 20 g.p.m.

11 Water sample submitted:
☐ Yes ☒ No Date

12 Well head completion: Top Cap
☐ Pitless adapter ☐ Inches above grade

13 Well grouted? ☒ Yes ☐ No
☒ Neat cement ☐ Bentonite ☐
Depth: From 5 ft. to 15 ft.

Nearest source of possible contamination: ★ Note #16
ft. None Visible Direction Type
Well disinfected upon completion? ☒ Yes ☐ No

15 Pump: ☒ Not installed
Manufacturer's name
Model number HP Volts
Length of drop pipe ft. capacity g.m.p.
Type:
☐ Submersible ☐ Turbine
☐ Jet ☐ Reciprocating
☐ Centrifugal ☐ Other

16 Remarks: elevation
896 DS open field WATERWAY 50' S

Topography:
☐ Hill
☐ Slope
☐ Upland
☒ Valley

17 Water well contractor's certification:
This well was drilled under my jurisdiction and this report is true to the best of my knowledge and belief.
STRADER Drlg Co Inc 182
Business name License No.
Address RT 1 Holton, KS
Signed Dale Strader Date 5-22-79
Authorized representative

Forward the white, blue and pink copies to the Kansas State Dept. Of Health.

Form WWC-5