


1 LOCATION OF WATER WELL: Fraction  $\frac{1}{4}$  SW  $\frac{1}{4}$  SW  $\frac{1}{4}$  SW Section Number 36 Township Number T 9 S Range Number R 21 E

Distance and direction from nearest town or city street address of well if located within city?  
 10 miles west 1 mile south of Leavenworth

2 WATER WELL OWNER: Chester Lewis  
 RR#, St. Address, Box #: 4905 10th Lansing, Ks. 66043  
 City, State, ZIP Code: Application Number: Board of Agriculture, Division of Water Resources

3 LOCATE WELL'S LOCATION WITH AN "X" IN SECTION BOX:

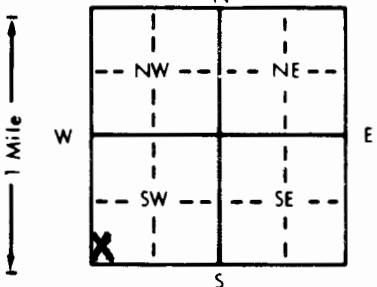

4 DEPTH OF COMPLETED WELL: 60 ft. ELEVATION: 42 ft.

Depth(s) Groundwater Encountered 1. 42 ft. 2. ft. 3. ft.  
 WELL'S STATIC WATER LEVEL 20 ft. below land surface measured on mo/day/yr 6-2-90  
 Pump test data: Well water was ft. after hours pumping 5 gpm  
 Est. Yield gpm: Well water was ft. after hours pumping gpm  
 Bore Hole Diameter 9 in. to 60 ft. and in. to ft.  
 WELL WATER TO BE USED AS:  
 (Domestic) 3 Feedlot 6 Oil field water supply 9 Dewatering 12 Other (Specify below)  
 2 Irrigation 4 Industrial 7 Lawn and garden only 10 Monitoring well  
 Was a chemical/bacteriological sample submitted to Department? Yes No X If yes, mo/day/yr sample was submitted Water Well Disinfected? (Yes) No

5 TYPE OF BLANK CASING USED:  
 1 Steel 3 RMP (SR) 5 Wrought iron 8 Concrete tile CASING JOINTS: (Glued) Clamped  
 (PVC) 4 ABS 6 Asbestos-Cement 9 Other (specify below) Welded  
 7 Fiberglass Threaded

Blank casing diameter 6 in. to 0-60 ft. Dia in. to ft. Dia in. to ft.  
 Casing height above land surface 24 in. weight lbs./ft. Wall thickness or gauge No. SCH 40

TYPE OF SCREEN OR PERFORATION MATERIAL:  
 1 Steel 3 Stainless steel 5 Fiberglass 7 PVC 10 Asbestos-cement  
 2 Brass 4 Galvanized steel 6 Concrete tile 8 RMP (SR) 11 Other (specify)  
 12 None used (open hole)

SCREEN OR PERFORATION OPENINGS ARE:  
 1 Continuous slot 3 Mill slot 5 Gauzed wrapped 8 Saw cut 11 None (open hole)  
 2 Louvered shutter 4 Key punched 6 Wire wrapped 9 Drilled holes  
 7 Torch cut 10 Other (specify)

SCREEN-PERFORATED INTERVALS: From 40 ft. to 60 ft. From ft. to ft. From ft. to ft. From ft. to ft.  
 GRAVEL PACK INTERVALS: From 20 ft. to 60 ft. From ft. to ft. From ft. to ft. From ft. to ft.

6 GROUT MATERIAL: 1 Neat cement 2 Cement grout 3 Bentonite 4 Other  
 Grout Intervals: From 3 ft. to 20 ft. From ft. to ft. From ft. to ft. From ft. to ft.

What is the nearest source of possible contamination:  
 1 Septic tank (Lateral lines) 7 Pit privy 11 Fuel storage 14 Abandoned water well  
 2 Sewer lines 5 Cess pool 8 Sewage lagoon 12 Fertilizer storage 15 Oil well/Gas well  
 3 Watertight sewer lines 6 Seepage pit 9 Feedyard 13 Insecticide storage 16 Other (specify below)

Direction from well? How many feet? 100

FROM	TO	LITHOLOGIC LOG	FROM	TO	PLUGGING INTERVALS
0	2	TOP SOIL			
2	28	BROWN CLAY			
28	42	GRAY SANDY CLAY			
42	60	SANDY GRAY CLAY			

7 CONTRACTOR'S OR LANDOWNER'S CERTIFICATION: This water well was (1) constructed, (2) reconstructed, or (3) plugged under my jurisdiction and was completed on (mo/day/year) 6-2-90 and this record is true to the best of my knowledge and belief. Kansas Water Well Contractor's License No. 526 This Water Well Record was completed on (mo/day/yr) 6-6-90 under the business name of NOLL Drilling by (signature) Fred Noll