


1 LOCATION OF WATER WELL: Fraction NW 1/4 NW 1/4 SE 1/4 Section Number 19 Township Number T 9 S Range Number R 21E E/W  
 County: LEAVENWORTH

Distance and direction from nearest town or city street address of well if located within city?  
 3/4 south, 3/4 east of Springdale

2 WATER WELL OWNER: Ronald Coffin  
 RR#, St. Address, Box #: 26148 231st McLouth, KS 66054 Board of Agriculture, Division of Water Resources  
 City, State, ZIP Code: Application Number:

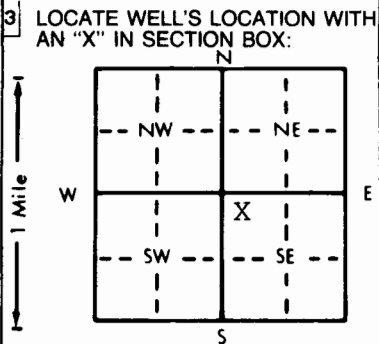

4 DEPTH OF COMPLETED WELL... 79' ft. ELEVATION: ... ft.  
 Depth(s) Groundwater Encountered 1. ... ft. 2. ... ft. 3. ... ft.  
 WELL'S STATIC WATER LEVEL ... 23' ft. below land surface measured on mo/day/yr 03/24/98  
 Pump test data: Well water was ... ft. after ... hours pumping ... gpm  
 Est. Yield 20 GPH gpm: Well water was ... ft. after ... hours pumping ... gpm  
 Bore Hole Diameter ... 12" in. to ... ft., and ... in. to ... ft.  
 WELL WATER TO BE USED AS: 5 Public water supply 8 Air conditioning 11 Injection well  
 1 Domestic 3 Feedlot 6 Oil field water supply 9 Dewatering 12 Other (Specify below)  
 2 Irrigation 4 Industrial 7 Lawn and garden only 10 Monitoring well  
 Was a chemical/bacteriological sample submitted to Department? Yes ... No X ... If yes, mo/day/yr sample was submitted  
 Water Well Disinfected? Yes X No

5 TYPE OF BLANK CASING USED: 5 Wrought iron 8 Concrete tile CASING JOINTS: Glued X Clamped  
 1 Steel 3 RMP (SR) 6 Asbestos-Cement 9 Other (specify below) Welded  
 2 PVC 4 ABS 7 Fiberglass Threaded  
 Blank casing diameter ... 5" in. to ... 10 ft., Dia ... 5" in. to ... 40-78 ft., Dia ... in. to ... ft.  
 Casing height above land surface ... 24" in., weight ... 2.82 lbs./ft. Wall thickness or gauge No. ... 258  
 TYPE OF SCREEN OR PERFORATION MATERIAL: 7 PVC 10 Asbestos-cement  
 1 Steel 3 Stainless steel 5 Fiberglass 8 RMP (SR) 11 Other (specify)  
 2 Brass 4 Galvanized steel 6 Concrete tile 9 ABS 12 None used (open hole)  
 SCREEN OR PERFORATION OPENINGS ARE: 5 Gauzed wrapped 8 Saw cut 11 None (open hole)  
 1 Continuous slot 3 Mill slot 6 Wire wrapped 9 Drilled holes  
 2 Louvered shutter 4 Key punched 7 Torch cut 10 Other (specify)  
 SCREEN-PERFORATED INTERVALS: From ... 10 ft. to ... 40 ft., From ... ft. to ... ft.  
 From ... 78 ft. to ... 79 ft., From ... ft. to ... ft.  
 GRAVEL PACK INTERVALS: From ... 8 ft. to ... 79 ft., From ... ft. to ... ft.  
 From ... ft. to ... ft., From ... ft. to ... ft.

6 GROUT MATERIAL: 1 Neat cement 2 Cement grout 3 Bentonite 4 Other  
 Grout Intervals: From ... 0 ft. to ... 8 ft., From ... ft. to ... ft., From ... ft. to ... ft.  
 What is the nearest source of possible contamination:  
 1 Septic tank 4 Lateral lines 7 Pit privy 10 Livestock pens 14 Abandoned water well  
 2 Sewer lines 5 Cess pool 8 Sewage lagoon 11 Fuel storage 15 Oil well/Gas well  
 3 Watertight sewer lines 6 Seepage pit 9 Feedyard 12 Fertilizer storage 16 Other (specify below)  
 13 Insecticide storage  
 Direction from well? East How many feet? 100'

FROM	TO	LITHOLOGIC LOG	FROM	TO	PLUGGING INTERVALS
0	1	Top Soil			
1	9	Clay-Brown			
9	11	Fine Sand-Brown			NOTE: 3/26/98 Permission to shallow grout from Don Taylor
11	24	Clay-Brown			
24	25	Fine Sand-Boulders			
25	28	Clay-Brown			
28	32	Boulders-FS-CS-Brown			
32	33	Fine Sand-Brown			
33	35	Clay-Blue			
35	36	Boulders			
36	41	Clay-Blue			
41	80	Shale-Grey			

7 CONTRACTOR'S OR LANDOWNER'S CERTIFICATION: This water well was (1) constructed, (2) reconstructed, or (3) plugged under my jurisdiction and was completed on (mo/day/year) 03/24/98 and this record is true to the best of my knowledge and belief. Kansas Water Well Contractor's License No. 182 This Water Well Record was completed on (mo/day/yr) 4-13-98 under the business name of STRADER DRILLING CO., INC. by (signature) Dale Skren

OFFICE USE ONLY  
T  
R  
EW  
SEC.