


MW-9

1 LOCATION OF WATER WELL: County: Leavenworth Fraction: SE 1/4 NW 1/4 NE 1/4 Section Number: 12 Township Number: T 9 S Range Number: R 22 EW

Distance and direction from nearest town or city street address of well if located within city?
3111 S. 4th, Leavenworth

2 WATER WELL OWNER: Carl's Gas Svc Attn: Fred Zoch Jr.
 RR#, St. Address, Box #: 3111 S. 4th, Leavenworth, KS 66048
 City, State, ZIP Code: Leavenworth, KS 66048
 Board of Agriculture, Division of Water Resources
 Application Number:

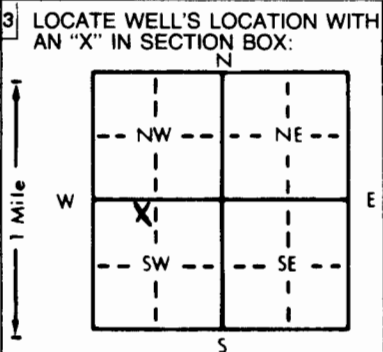

4 DEPTH OF COMPLETED WELL: _____ ft. ELEVATION: _____ ft.
 Depth(s) Groundwater Encountered 1. _____ ft. 2. _____ ft. 3. _____ ft.
 WELL'S STATIC WATER LEVEL: 8.15 ft. below land surface measured on mo/day/yr 4-3-96
 Pump test data: Well water was _____ ft. after _____ hours pumping _____ gpm
 Est. Yield _____ gpm: Well water was _____ ft. after _____ hours pumping _____ gpm
 Bore Hole Diameter _____ in. to _____ ft., and _____ in. to _____ ft.
 WELL WATER TO BE USED AS:
 5 Public water supply 8 Air conditioning 11 Injection well
 1 Domestic 3 Feedlot 6 Oil field water supply 9 Dewatering 12 Other (Specify below)
 2 Irrigation 4 Industrial 7 Lawn and garden only Monitoring well Aband due to construction
 Was a chemical/bacteriological sample submitted to Department? Yes _____ No _____; If yes, mo/day/yr sample was submitted _____
 Water Well Disinfected? Yes No _____

5 TYPE OF BLANK CASING USED:
 1 Steel 3 RMP (SR) 5 Wrought iron 8 Concrete tile CASING JOINTS: Glued _____ Clamped _____
 2 PVC 4 ABS 6 Asbestos-Cement 9 Other (specify below) Welded _____
 7 Fiberglass Threaded
 Blank casing diameter 2 in. to 10 ft., Dia _____ in. to _____ ft., Dia _____ in. to _____ ft.
 Casing height above land surface _____ in., weight _____ lbs./ft. Wall thickness or gauge No. _____
 TYPE OF SCREEN OR PERFORATION MATERIAL:
 1 Steel 3 Stainless steel 5 Fiberglass 7 PVC 10 Asbestos-cement
 2 Brass 4 Galvanized steel 6 Concrete tile 8 RMP (SR) 11 Other (specify) _____
 9 ABS 12 None used (open hole)
 SCREEN OR PERFORATION OPENINGS ARE:
 1 Continuous slot 3 Mill slot 5 Gauzed wrapped 8 Saw cut 11 None (open hole)
 2 Louvered shutter 4 Key punched 6 Wire wrapped 9 Drilled holes
 7 Torch cut 10 Other (specify) _____
 SCREEN-PERFORATED INTERVALS: From 10 ft. to 20 ft., From _____ ft. to _____ ft.
 From _____ ft. to _____ ft., From _____ ft. to _____ ft.
 GRAVEL PACK INTERVALS: From _____ ft. to _____ ft., From _____ ft. to _____ ft.
 From _____ ft. to _____ ft., From _____ ft. to _____ ft.

6 GROUT MATERIAL: 1 ~~Neat cement~~ Soil 2 Cement grout 3 Bentonite 4 Other Chlorinated Sand
 Grout Intervals: From GL ft. to 3 ft., From 3 ft. to 8 ft., From 8 ft. to 20 ft.
 What is the nearest source of possible contamination:
 1 Septic tank 4 Lateral lines 7 Pit privy 10 Livestock pens 14 Abandoned water well
 2 Sewer lines 5 Cess pool 8 Sewage lagoon 11 Fuel storage 15 Oil well/Gas well
 3 Watertight sewer lines 6 Seepage pit 9 Feedyard 12 Fertilizer storage 16 Other (specify below)
 13 Insecticide storage
 Direction from well? _____ How many feet? N/A

FROM	TO	LITHOLOGIC LOG	FROM	TO	PLUGGING INTERVALS
GL	3	Soil	GL	3	Soil
3	8	Bentonite	3	8	Bentonite
8	20	Chlorinated Sand	8	20	Chlorinated Sand
		<u>Plugged</u>			

7 CONTRACTOR'S OR LANDOWNER'S CERTIFICATION: This water well was (1) constructed, (2) reconstructed, or plugged under my jurisdiction and was completed on (mo/day/year) 4-3-96 and this record is true to the best of my knowledge and belief. Kansas Water Well Contractor's License No. 585 This Water Well Record was completed on (mo/day/yr) 4-12-96 under the business name of Associated Environmental, Inc by (signature) D Johnson for Darin Duncan