


1 LOCATION OF WATER WELL: Fraction NW 1/4 SW 1/4 SW 1/4 Section Number 15 Township Number T 9 S Range Number R 22E E/W
 County: LEAVENWORTH

Distance and direction from nearest town or city street address of well if located within city?
 2 west, 1 north of Lansing

2 WATER WELL OWNER: Tom Portenier, Jr.
 RR#, St. Address, Box #: 16048 New Lawrence Dr. Breuer job Board of Agriculture, Division of Water Resources
 City, State, ZIP Code: Leavenworth, KS 66048 Application Number:

3 LOCATE WELL'S LOCATION WITH AN "X" IN SECTION BOX: 4 DEPTH OF COMPLETED WELL: 140' ft. ELEVATION:

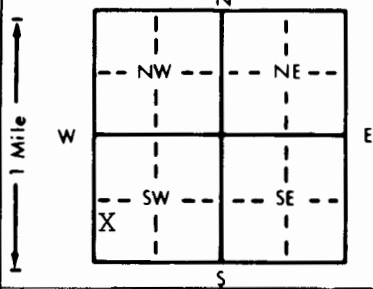

Depth(s) Groundwater Encountered 1. ft. 2. ft. 3. ft.
 WELL'S STATIC WATER LEVEL . . . 60' . . . ft. below land surface measured on mo/day/yr . . . 5/5/97
 Pump test data: Well water was ft. after hours pumping gpm
 Est. Yield . . . 4 . . . gpm: Well water was ft. after hours pumping gpm
 Bore Hole Diameter . . . 8 3/4 in. to ft., and in. to ft.
 WELL WATER TO BE USED AS: 5 Public water supply 8 Air conditioning 11 Injection well
 1 Domestic 3 Feedlot 6 Oil field water supply 9 Dewatering 12 Other (Specify below)
 2 Irrigation 4 Industrial 7 Lawn and garden only 10 Monitoring well
 Was a chemical/bacteriological sample submitted to Department? Yes No ; If yes, mo/day/yr sample was submitted
 Water Well Disinfected? Yes No

5 TYPE OF BLANK CASING USED: 5 Wrought iron 8 Concrete tile CASING JOINTS: Glued Clamped
 1 Steel 3 RMP (SR) 6 Asbestos-Cement 9 Other (specify below) Welded
 2 PVC 4 ABS 7 Fiberglass Threaded

Blank casing diameter . . . 5" . . . in. to . . . 0-60 . . . ft., Dia . . . 5" . . . in. to . . . 100-139 . . . ft., Dia . . . in. to . . . ft.
 Casing height above land surface . . . 24" . . . in., weight . . . 2.82 . . . lbs./ft. Wall thickness or gauge No. . . 258

TYPE OF SCREEN OR PERFORATION MATERIAL: 7 PVC 10 Asbestos-cement
 1 Steel 3 Stainless steel 5 Fiberglass 8 RMP (SR) 11 Other (specify)
 2 Brass 4 Galvanized steel 6 Concrete tile 9 ABS 12 None used (open hole)

SCREEN OR PERFORATION OPENINGS ARE: 5 Gauzed wrapped 8 Saw cut 11 None (open hole)
 1 Continuous slot 3 Mill slot 6 Wire wrapped 9 Drilled holes
 2 Louvered shutter 4 Key punched 7 Torch cut 10 Other (specify)

SCREEN-PERFORATED INTERVALS: From . . . 60 . . . ft. to . . . 100 . . . ft., From . . . ft. to . . . ft.
 From . . . 139 . . . ft. to . . . 140 . . . ft., From . . . ft. to . . . ft.
 GRAVEL PACK INTERVALS: From . . . 24 . . . ft. to . . . 140 . . . ft., From . . . ft. to . . . ft.
 From . . . ft. to . . . ft., From . . . ft. to . . . ft.

6 GROUT MATERIAL: 1 Neat cement 2 Cement grout 3 Bentonite 4 Other
 Grout Intervals: From . . . 4 . . . ft. to . . . 24 . . . ft., From . . . ft. to . . . ft., From . . . ft. to . . . ft.

What is the nearest source of possible contamination: 10 Livestock pens 14 Abandoned water well
 1 Septic tank 4 Lateral lines 7 Pit privy 11 Fuel storage 15 Oil well/Gas well
 2 Sewer lines 5 Cess pool 8 Sewage lagoon 12 Fertilizer storage 16 Other (specify below)
 3 Watertight sewer lines 6 Seepage pit 9 Feedyard 13 Insecticide storage

Direction from well? north How many feet? 250'

FROM	TO	LITHOLOGIC LOG	FROM	TO	PLUGGING INTERVALS
0	2	Top Soil			
2	5	Clay-Brown			
5	9	Shale-Yellow			
9	10	Limestone-Tan			
10	12	Shale-Yellow			
12	42	Sandstone-Brown			
42	51	Sandy Shale-Grey			
51	53	Sandstone-Grey			
53	55	Shale-Grey			
55	74	Sandstone-Grey			
74	77	Shale-Grey			
77	86	Sandstone-Grey			
86	127	Shale-Grey			
127	128	Limestone-Grey			
128	140	Shale-Grey			

7 CONTRACTOR'S OR LANDOWNER'S CERTIFICATION: This water well was (1) constructed, (2) reconstructed, or (3) plugged under my jurisdiction and was completed on (mo/day/year) . . . 5/5/97 . . . and this record is true to the best of my knowledge and belief. Kansas Water Well Contractor's License No. . . . 182 . . . This Water Well Record was completed on (mo/day/yr) . . . 5-21-97 . . . under the business name of STRADER DRILLING CO., INC. by (signature) Dale Strader

OFFICE USE ONLY
T
R
EW
SEC.
1/4
1/4
1/4